

USE TYPEWRITER OR BALL
POINT PEN—PRESS FIRMLY,
PRINT CLEARLY.

SPEARVILLE


T R EW sec 1/4 1/4 1/4 No.

WATER WELL RECORD
KSA 82a-1201-1215

Kansas State Dept. Of Health
(Water Well Contractors)
Forbes-Bldg. 740
Topeka, Kansas 66620

1 Location of well:	County Ford	Township name Spearville	Fraction NW¹/₄ of NE¹/₄	Section number 2	Town number T-26-S	Range number R-23-W
---------------------	-----------------------	------------------------------------	---	----------------------------	------------------------------	-------------------------------

Distance and direction from nearest town or city: 3 mi southwest of Spearville Street address of well location if in city:	3 Owner of well: Clarence Schuette Address: Spearville, Kansas
---	---

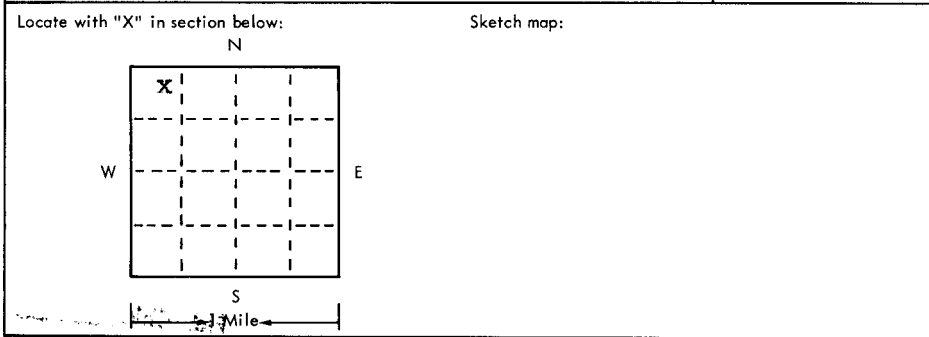

2	Type and color of material.	From	To

4 Well depth: 380 ft. Date of completion 11-26-74
Well diameter 26 in.

5 Cable tool Rotary Driven Dug
 Hollow rod Jetted Bored Reverse rotary

6 Use: Domestic Public supply Industry
 Irrigation Air conditioning Commercial
 Test well

7 Casing: Material metal Height: above/below
Threaded Welded Surface in.
Diam. 380 (Weight lbs./ft.)
 in. to ft. depth! Drive shoe? Yes No
 in. to ft. depth!

8 Screen:
Manufacturer 10% Free-flo (W.A. Brown)
Type ### Dia. 16
Slot/gauze 1/8 Length 2"
Set between 50 ft. and 90 ft. 190-380
Fittings:
Gravel pack Yes No Size range of material 1/2

9 Static water level:
52 ft. below land surface Date 11-26-74

10 Pumping level below land surfaces: NA
 ft. after hrs. pumping g.p.m.
 ft. after hrs. pumping g.p.m.
Estimated maximum yield g.p.m.

11 Water sample submitted:
 Yes No Date

12 Well head completion:
 Pitless adapter Inches above grade

13 Well grouted? Yes No
 Neat cement Bentonite
Depth: From ft. to ft.

14 Nearest source of possible contamination: NA
ft. Direction Type
Well disinfected upon completion? Yes No

15 Pump: Not installed 4-23-75
Manufacturer's name Goulds
Model number 12JHO HP 100 Volts 460
Length of drop pipe 300 ft. capacity 1200 g.m.p.
Type:
 Submersible Turbine
 Jet Reciprocating
 Centrifugal Other

16 Remarks: elevation

Topography:
 Hill
 Slope
 Upland
 Valley 1010

2453

17 Water well contractor's certification:
This well was drilled under my jurisdiction and this
report is true to the best of my knowledge and belief.
Ace-Hi Drilling Co 190
Business name
Address Box 1442, Dodge City, Ks License No.
Signed Carl G. ... Date 5-7-75
Authorized representative