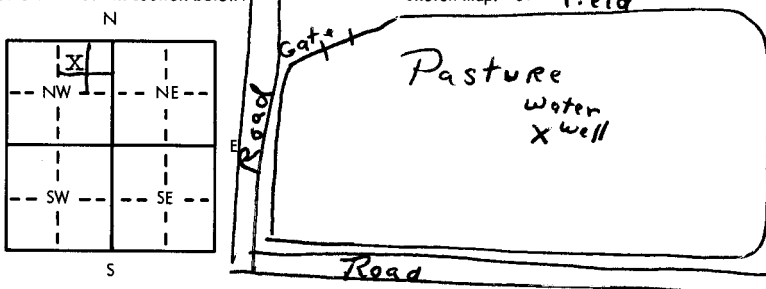


USE TYPEWRITER OR BALL POINT PEN-PRESS FIRMLY, PRINT CLEARLY.

WATER WELL RECORD
KSA 82a-1201-1215

Kansas Department of Health and Environment-Division of Environment
(Water well Contractors)
Topeka, Kansas 66620

BAR

1. Location of well:	County: Ford	Fraction: NW 1/4 NE 1/4 NW 1/4	Section number: 5	Township number: T 26 S	Range number: R 23 E																				
2. Distance and direction from nearest town or city: 7 Miles East of Wright, Kansas Street address of well location if in city: 1/2 E - 3/4 N of Wright, Kansas			3. Owner of well: John Collingwood R.R. or street: P.O. Box 4487 City, state, zip code: Topeka, Kansas 66603																						
4. Locate with "X" in section below: 			6. Bore hole dia. 9.75 in. Completion date: 6-8-77 Well depth 85 ft.																						
5. Type and color of material: <table border="1" style="width:100%; border-collapse: collapse;"> <thead> <tr> <th>From</th> <th>To</th> </tr> </thead> <tbody> <tr> <td>Surface</td> <td>3</td> </tr> <tr> <td>Caliche clay</td> <td>15</td> </tr> <tr> <td>Sand rock</td> <td>40</td> </tr> <tr> <td>Gray and yellow clay</td> <td>65</td> </tr> <tr> <td>Half sand stone and half clay</td> <td>80</td> </tr> <tr> <td>Shale</td> <td>90</td> </tr> <tr> <td colspan="2" style="text-align:center;">BRICK 40'</td> </tr> <tr> <td colspan="2" style="text-align:center;">26</td> </tr> <tr> <td colspan="2" style="text-align:center;">14' sat thick</td> </tr> </tbody> </table>			From	To	Surface	3	Caliche clay	15	Sand rock	40	Gray and yellow clay	65	Half sand stone and half clay	80	Shale	90	BRICK 40'		26		14' sat thick		7. <input checked="" type="checkbox"/> Cable tool <input checked="" type="checkbox"/> Rotary <input type="checkbox"/> Driven <input type="checkbox"/> Dug <input type="checkbox"/> Hollow rod <input type="checkbox"/> Jetted <input type="checkbox"/> Bored <input type="checkbox"/> Reverse rotary		
From	To																								
Surface	3																								
Caliche clay	15																								
Sand rock	40																								
Gray and yellow clay	65																								
Half sand stone and half clay	80																								
Shale	90																								
BRICK 40'																									
26																									
14' sat thick																									
8. Use: <input type="checkbox"/> Domestic <input type="checkbox"/> Public supply <input type="checkbox"/> Industry <input type="checkbox"/> Irrigation <input type="checkbox"/> Air conditioning <input checked="" type="checkbox"/> Stock <input type="checkbox"/> Lawn <input type="checkbox"/> Oil field water <input type="checkbox"/> Other			9. Casing: Material pvc Height: Above or below Threaded: <input type="checkbox"/> Welded <input checked="" type="checkbox"/> Surface 1.8 in. RMP <input checked="" type="checkbox"/> PVC <input type="checkbox"/> Weight 1.8 lbs./ft. Dia. 5 in. to 85 ft. depth Wall Thickness: inches or Dia. <input type="checkbox"/> in. to <input type="checkbox"/> ft. depth Gage No. 0.250																						
10. Screen: Manufacturer's name: Jess and Lowell Type RMP Dia. 5 in. Slot/gauze .06 Length 30 ft. Set between 55 ft. and 85 ft. ft. and <input type="checkbox"/> ft. Gravel pack <input checked="" type="checkbox"/> Size range of material 1/4-1/8			11. Static water level: 26 ft. below land surface Date 6-8-77 mo./day/yr.																						
12. Pumping level below land surfaces: ____ ft. after ____ hrs. pumping ____ g.p.m. ____ ft. after ____ hrs. pumping ____ g.p.m. Estimated maximum yield ____ g.p.m.			13. Water sample submitted: ____ mo./day/yr. Yes <input type="checkbox"/> No <input checked="" type="checkbox"/> Date ____																						
14. Well head completion: nc <input type="checkbox"/> Pitless adapter ____ inches above grade			15. Well grouted? yes With: <input type="checkbox"/> Neat cement <input checked="" type="checkbox"/> Bentonite <input type="checkbox"/> Concrete Depth: From 0 ft. to 13 ft.																						
16. Nearest source of possible contamination: nc ft. ____ Direction ____ Type ____ Well disinfected upon completion? Yes <input type="checkbox"/> No <input checked="" type="checkbox"/>			17. Pump: <input checked="" type="checkbox"/> Not installed Manufacturer's name ____ Model number ____ HP ____ Volts ____ Length of drop pipe ____ ft. capacity ____ g.p.m. Type: <input type="checkbox"/> Submersible <input type="checkbox"/> Turbine <input type="checkbox"/> Jet <input type="checkbox"/> Reciprocating <input type="checkbox"/> Centrifugal <input type="checkbox"/> Other																						
18. Elevation:			19. Remarks: TOPO. 2461 40 2421																						
20. Water well contractor's certification: This well was drilled under my jurisdiction and this report is true to the best of my knowledge and belief. Hodde Drilling Co. 302 Business name License No. ____ Address R.R. #1 Dodge City, KS Signed Willie Hodde Jr. Date 6-15-77 Authorized representative			26 230 5 CDR NE NW 1/4 1/4 1/4																						