

USE TYPEWRITER OR BALL POINT PEN-PRESS FIRMLY, PRINT CLEARLY.

SPEARVILLE

T R EW sec 1/4 1/4 1/4 No.


WATER WELL RECORD  
KSA 82a-1201-1215

Kansas State Dept. Of Health  
(Water Well Contractors)  
Forbes-Bldg. 740  
Topeka, Kansas 66620

1 Location of well: County **Ford** Township name **Spearville** Fraction **NW 1/4 SW 1/4 SW 1/4** Section number **21** Town number **T 26** Range number **R 23 W**

Distance and direction from nearest town or city:  
**2 mi east, 3/4 mi south of Wright Ks**  
Street address of well location if in city:

3 Owner of well:  
**Stanley Kliesen**  
Address: **Wright, Ks. 67882**

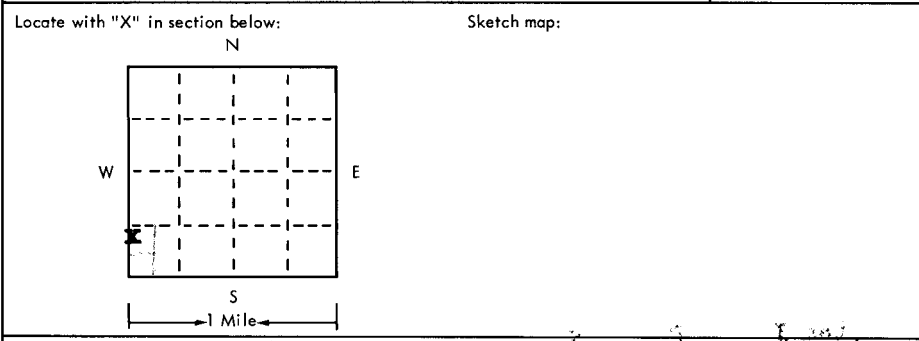

4 Well depth: **348** ft. Date of completion **10-17-75**  
Well diameter **26** in.

5  Cable tool  Rotary  Driven  Dug  
 Hollow rod  Jetted  Bored  Reverse rotary

6 Use:  Domestic  Public supply  Industry  
 Irrigation  Air conditioning  Commercial  
 Test well

7 Casing: Material **Steel** Height: **above**/below  
Threaded  Welded  Surface **12** in.  
Diam. Weight **219** lbs./ft.  
**16** in. to **348** ft. depth Drive shoe?  Yes  No

Type and color of material	From	To
Clay	0	20
Gyp	20	80
Clay	80	100
Clay, sandstone	100	120
Clay	120	140
Sandstone, clay	140	160
Sandstone, clay	160	200
Clay	200	240
Sandstone	240	350
Red bed, some sandstone	350	360
Clay, some sandstone, several kelly drop	360	380
TROCK 120'		
42 78 sat thick		
Oump ordered, set sometime in early Nov.		
(use a second sheet if needed)		

8 Screen:  
Manufacturer **Lakewood**  
Type **Millslot** Dia. **16"**  
Slot gauge **1/8** Length **2"**  
Set between **118** ft. and **198** ft.  
Fittings: **228** **348** **1x5/8**  
Gravel pack  Yes  No Size range of material

9 Static water level:  
**42** ft. below land surface Date **10/17/75**

10 Pumping level below land surfaces:  
**42** ft. after **6 days** pumping **600** g.p.m.  
ft. after \_\_\_ hrs. pumping \_\_\_ g.p.m.  
Estimated maximum yield **700** g.p.m.

11 Water sample submitted:  
 Yes  No Date

12 Well head completion:  
 Pitless adapter  Inches above grade

13 Well grouted?  Yes  No  
 Neat cement  Bentonite   
Depth: From **0** ft. to **10** ft.

14 Nearest source of possible contamination: **NA**  
ft. Direction Type  
Well disinfected upon completion?  Yes  No

15 Pump:  Not installed  
Manufacturer's name **Worthington**  
Model number **8S-12M-75** Volts  
Length of drop pipe **345** ft. capacity **700** g.p.m.  
Type:  
 Submersible  Turbine  
 Jet  Reciprocating  
 Centrifugal  Other

16 Remarks: elevation  
  
Topography:  
 Hill  
 Slope  
 Upland **level**  
 Valley  
**TOPO**

17 Water well contractor's certification:  
This well was drilled under my jurisdiction and this report is true to the best of my knowledge and belief.  
**High Plains Drilling & Supply, Inc 136**  
Business name License No.  
Address **102 N 3rd Garden City, Ks.**  
Signed **Sec 21** Date **11-3-75**

26  
23 W  
21 NW SW SW