


1 LOCATION OF WATER WELL: County: Ford	Fraction NE 1/4 NE 1/4 NW 1/4	Section Number 23	Township Number T 26 S	Range Number R 23 EW
---	----------------------------------	----------------------	---------------------------	-------------------------

Distance and direction from nearest town or city street address of well if located within city?  
From Wright, Ks. - 5 miles East on Wright-Windhorst blacktop road

2 WATER WELL OWNER: Frank Lorimor  
RR#, St. Address, Box # :  
City, State, ZIP Code : Spearville, Kansas 67876  
Board of Agriculture, Division of Water Resources  
Application Number:

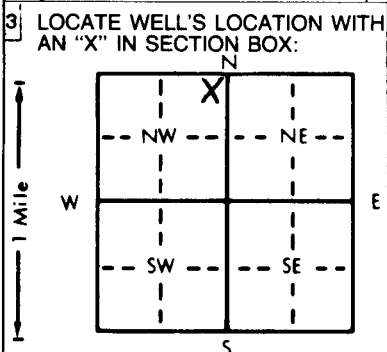

4 DEPTH OF COMPLETED WELL: 185 ft. ELEVATION:  
Depth(s) Groundwater Encountered 1. ft. 2. ft. 3. ft.  
WELL'S STATIC WATER LEVEL: 69 ft. below land surface measured on mo/day/yr 1-10-91  
Pump test data: Well water was ft. after hours pumping gpm  
Est. Yield gpm: Well water was ft. after hours pumping gpm  
Bore Hole Diameter: 10 in. to 185 ft., and in. to ft.  
WELL WATER TO BE USED AS:  
5 Public water supply 8 Air conditioning 11 Injection well  
1 Domestic 3 Feedlot 6 Oil field water supply 9 Dewatering 12 Other (Specify below)  
2 Irrigation 4 Industrial 7 Lawn and garden only 10 Monitoring well  
Was a chemical/bacteriological sample submitted to Department? Yes No XX; If yes, mo/day/yr sample was submitted  
Water Well Disinfected? Yes xx No

5 TYPE OF BLANK CASING USED:  
1 Steel 3 RMP (SR) 5 Wrought iron 8 Concrete tile CASING JOINTS: Glued XX Clamped  
2 PVC 4 ABS 6 Asbestos-Cement 9 Other (specify below) Welded  
7 Fiberglass Threaded  
Blank casing diameter 5 in. to 185 ft., Dia in. to ft., Dia in. to ft.  
Casing height above land surface 12 in., weight 200 psi lbs./ft. Wall thickness or gauge No. SDR 21  
TYPE OF SCREEN OR PERFORATION MATERIAL:  
1 Steel 3 Stainless steel 5 Fiberglass 8 RMP (SR) 10 Asbestos-cement  
2 Brass 4 Galvanized steel 6 Concrete tile 9 ABS 11 Other (specify)  
12 None used (open hole)  
SCREEN OR PERFORATION OPENINGS ARE:  
1 Continuous slot 3 Mill slot 5 Gauzed wrapped 8 Saw cut 11 None (open hole)  
2 Louvered shutter 4 Key punched 6 Wire wrapped 9 Drilled holes  
7 Torch cut 10 Other (specify)  
SCREEN-PERFORATED INTERVALS: From 160 ft. to 180 ft., From ft. to ft.  
GRAVEL PACK INTERVALS: From 25 ft. to 185 ft., From ft. to ft.

6 GROUT MATERIAL: 1 Neat cement 2 Cement grout 3 Bentonite 4 Other benseal  
Grout Intervals: From 5 ft. to 25 ft., From ft. to ft., From ft. to ft.  
What is the nearest source of possible contamination:  
1 Septic tank 4 Lateral lines 7 Pit privy 10 Livestock pens 14 Abandoned water well  
2 Sewer lines 5 Cess pool 8 Sewage lagoon 11 Fuel storage 15 Oil well/Gas well  
3 Watertight sewer lines 6 Seepage pit 9 Feedyard 12 Fertilizer storage 16 Other (specify below)  
13 Insecticide storage  
Direction from well? Northeast How many feet? 100

FROM	TO	LITHOLOGIC LOG	FROM	TO	PLUGGING INTERVALS
0	20	Top soil, clay & thin rock layers			
20	40	Rock layers & gray clay			
40	60	Gray clay			
60	100	Gray clay & thin sand stone layers			
100	140	Sand stone & clay layers (gray)			
140	160	Tan clay (5 ft.) & tan sand stone			
160	180	Sand stone			
180	200	Sand stone & clay (15 ft.)			

7 CONTRACTOR'S OR LANDOWNER'S CERTIFICATION: This water well was (1) constructed, (2) reconstructed, or (3) plugged under my jurisdiction and was completed on (mo/day/year) Jan. 11, 1991 and this record is true to the best of my knowledge and belief. Kansas Water Well Contractor's License No. 179 This Water Well Record was completed on (mo/day/yr) Jan. 31, 1991 under the business name of Joe's Well Service, Inc. Cimarron, Ks. by (signature) Judith Creek