

USE TYPEWRITER OR BALL POINT PEN-PRESS FIRMLY, PRINT CLEARLY.

WATER WELL RECORD  
KSA 82a-1201-1215


Kansas Department of Health and Environment-Division of Environment (Water well Contractors) Topeka, Kansas 66620

WRIGHT

C A (center)

1. Location of well: County **Ford** Fraction **C 1/4 NE 1/4 SW 1/4** Section number **30** Township number **T 26 S R 23 E/W**

2. Distance and direction from nearest town or city: **1 1/4 mi. So. of Wright, Kansas.**  
Street address of well location if in city:  
3. Owner of well: **Pickrell Drilling Co. Litwin Bldg. Suite 205 Wichita, Kansas 67202**  
R.R. or street:  
City, state, zip code:

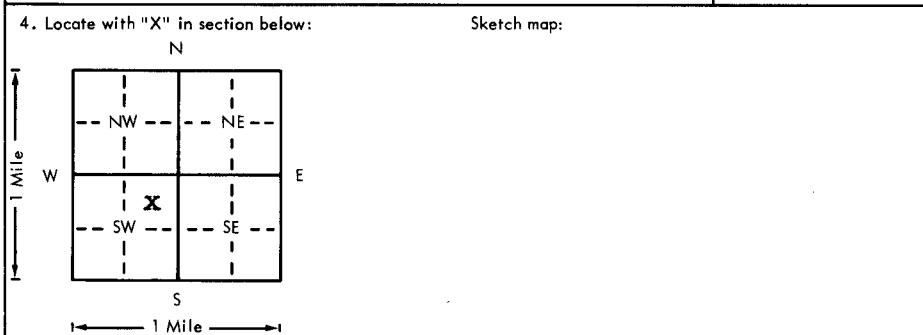

6. Bore hole dia. **9 7/8** in. Completion date \_\_\_\_\_  
Well depth **150** ft. **4-18-78**

7.  Cable tool  Rotary  Driven  Dug  
 Hollow rod  Jetted  Bored  Reverse rotary

8. Use:  Domestic  Public supply  Industry  
 Irrigation  Air conditioning  Stock  
 Lawn  Oil field water  Other

9. Casing: Material **pvc** Height: Above or ~~below~~  
Threaded  Welded  Surface **24** in.  
RMP  PVC  Weight \_\_\_\_\_ lbs./ft.  
Dia. **4** in. to **150** ft. depth Wall Thickness: inches or  
Dia. \_\_\_\_\_ in. to \_\_\_\_\_ ft. depth gage No. **.237**

| 5. Type and color of material                    | From | To  |
|--|------|-----|
| Black top soil                                   | 0    | 3   |
| Brown clay                                       | 3    | 7   |
| Red Brown clay                                   | 7    | 29  |
| Brown & white clay                               | 29   | 33  |
| Hard white clay                                  | 33   | 49  |
| Brown clay streaks, hard white clay w/sandtraces | 49   | 120 |
| Red & white clay                                 | 120  | 130 |
| Brown clay                                       | 130  | 145 |
| Sand & gravel                                    | 145  | 147 |
| Grey clay  | 147  | 153 |
| Shale  | 153  | 158 |
| BR ROCK 147                                      |      |     |
| 80<br>67' sat thick                              |      |     |
| in Og  |      |     |
| (Use a second sheet if needed)                   |      |     |

10. Screen: Manufacturer's name **CertainTeed**  
Type **pvc** Dia. \_\_\_\_\_  
Slot/size **1/16** Length **20 + 10**  
Set between **100** ft. and **120** ft.  
**140** ft. and **150** ft.  
Gravel pack?  Size range of material **3/4 3/8**

11. Static water level: \_\_\_\_\_ mo./day/yr.  
**80** ft. below land surface Date **4-18-78**

12. Pumping level below land surfaces: **NA**  
\_\_\_\_\_ ft. after \_\_\_\_\_ hrs. pumping \_\_\_\_\_ g.p.m.  
\_\_\_\_\_ ft. after \_\_\_\_\_ hrs. pumping \_\_\_\_\_ g.p.m.  
Estimated maximum yield \_\_\_\_\_ g.p.m.

13. Water sample submitted: \_\_\_\_\_ mo./day/yr.  
Yes  No  Date \_\_\_\_\_

14. Well head completion: \_\_\_\_\_  
Pitless adapter \_\_\_\_\_ Inches above grade

15. Well grouted?   
With:  Neat cement  Bentonite  Concrete  
Depth: From **0** ft. to **10** ft.

16. Nearest source of possible contamination:  
ft. **100** Direction **SW** Type **oilwell**  
Well disinfected upon completion? **HTH** Yes  No

17. Pump:  Not installed  
Manufacturer's name \_\_\_\_\_  
Model number \_\_\_\_\_ HP \_\_\_\_\_ Volts \_\_\_\_\_  
Length of drop pipe \_\_\_\_\_ ft. capacity \_\_\_\_\_ g.p.m.  
Type:  
 Submersible  Turbine  
 Jet  Reciprocating  
 Centrifugal  Other

18. Elevation:  
Topography:  
 Hill  
 Slope  
 Upland  
 Valley

19. Remarks:  
**TOPD**

20. Water well contractor's certification:  
This well was drilled under my jurisdiction and this report is true to the best of my knowledge and belief.  
**Rosencrantz-Bemis 134**  
Business name License No.  
Address **Great Bend, Kansas 67530**  
Signed **Sandy Kilgore** Date **4-26-78**  
Authorized representative

26  
230  
30  
CNE  
1/4  
1/4  
1/4

2509  
147  
2362V