


1 LOCATION OF WATER WELL: County: Ford	Fraction NW 1/4 NW 1/4 NW 1/4	Section Number 31	Township Number T 26 S	Range Number R 23 E/W
---	----------------------------------	----------------------	---------------------------	--------------------------

Distance and direction from nearest town or city street address of well if located within city?
From Wright - on Wright blacktop 2 miles South & 1 mile East

2 WATER WELL OWNER: Rod Helfrich
RR#, St. Address, Box # :
City, State, ZIP Code : Wright, Kansas 67882

Board of Agriculture, Division of Water Resources
Application Number:

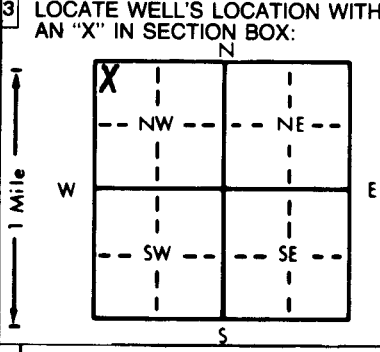

4 DEPTH OF COMPLETED WELL... 165 ft. ELEVATION:

Depth(s) Groundwater Encountered 1.....ft. 2.....ft. 3.....ft.

WELL'S STATIC WATER LEVEL ... 71 ft. below land surface measured on mo/day/yr ... 5-30-91

Pump test data: Well water was ft. after hours pumping gpm

Est. Yield ... 35 gpm: Well water was ft. after hours pumping gpm

Bore Hole Diameter ... 10 in. to ... 165 ft., and in. to ft.

WELL WATER TO BE USED AS:

5 Public water supply	8 Air conditioning	11 Injection well
1 Domestic	3 Feedlot	6 Oil field water supply
2 Irrigation	4 Industrial	7 Lawn and garden only
		10 Monitoring well

12 Other (Specify below)

Was a chemical/bacteriological sample submitted to Department? Yes.....No...XX.....; If yes, mo/day/yr sample was submitted

Water Well Disinfected? Yes xx No

5 TYPE OF BLANK CASING USED:

1 Steel	3 RMP (SR)	5 Wrought iron	8 Concrete tile	CASING JOINTS: Glued . XX . Clamped
2 PVC	4 ABS	6 Asbestos-Cement	9 Other (specify below)	Welded
		7 Fiberglass		Threaded

Blank casing diameter 5 in. to ... 165 ft., Dia in. to ft., Dia in. to ft.

Casing height above land surface 12 in., weight 200 psi lbs./ft. Wall thickness or gauge No. SDR 21

TYPE OF SCREEN OR PERFORATION MATERIAL:

1 Steel	3 Stainless steel	5 Fiberglass	7 PVC	10 Asbestos-cement
2 Brass	4 Galvanized steel	6 Concrete tile	8 RMP (SR)	11 Other (specify)
			9 ABS	12 None used (open hole)

SCREEN OR PERFORATION OPENINGS ARE:

1 Continuous slot	3 Mill slot	5 Gauzed wrapped	8 Saw cut	11 None (open hole)
2 Louvered shutter	4 Key punched	6 Wire wrapped	9 Drilled holes	
		7 Torch cut	10 Other (specify)	

SCREEN-PERFORATED INTERVALS: From 120 ft. to ... 160 ft., From ft. to ft.

GRAVEL PACK INTERVALS: From 40 ft. to ... 165 ft., From ft. to ft.

6 GROUT MATERIAL: 1 Neat cement 2 Cement grout 3 Bentonite 4 Other .. hole plug.....

Grout Intervals: From 5 ft. to ... 40 ft., From ft. to ft., From ft. to ft.

What is the nearest source of possible contamination: none - new bldg. site 10 Livestock pens 14 Abandoned water well

1 Septic tank	4 Lateral lines	7 Pit privy	11 Fuel storage	15 Oil well/Gas well
2 Sewer lines	5 Cess pool	8 Sewage lagoon	12 Fertilizer storage	16 Other (specify below)
3 Watertight sewer lines	6 Seepage pit	9 Feedyard	13 Insecticide storage	

Direction from well? How many feet?

FROM	TO	LITHOLOGIC LOG	FROM	TO	PLUGGING INTERVALS
0	20	Top soil & clay			
20	40	Clay			
40	80	Clay & sand rock in layers			
80	100	Clay & fine sand in layers			
100	120	Fine sand			
120	140	Fine to medium sand & clay (5 ft.)			
140	165	Fine to coarse sand w/small gravel			
165	180	Clay & blue shale			

RECEIVED

JUN 19 1991

DIVISION OF ENVIRONMENT

7 CONTRACTOR'S OR LANDOWNER'S CERTIFICATION: This water well was (1) constructed, (2) reconstructed, or (3) plugged under my jurisdiction and was completed on (mo/day/year) 5-31-91 and this record is true to the best of my knowledge and belief. Kansas Water Well Contractor's License No. 179 This Water Well Record was completed on (mo/day/yr) ... 6-4-91 under the business name of Joe's Well Service, Inc. Cimarron, Ks. by (signature) *Josid Creek*

INSTRUCTIONS: Use typewriter or ball point pen. PLEASE PRESS FIRMLY and PRINT clearly. Please fill in blanks, underline or circle the correct answers. Send top three copies to Kansas Department of Health and Environment, Bureau of Water, Topeka, Kansas 66620-7320. Telephone: 913-296-5545. Send one to WATER WELL OWNER and retain one for your records.