


1 LOCATION OF WATER WELL:	Fraction	Section Number	Township Number	Range Number
County: <b>Frod</b>	NW 1/4 NW 1/4 NW 1/4	36	T 26 S	R 23 E/W

Distance and direction from nearest town or city street address of well if located within city?  
**From Wright, Kansas - 2 miles South & 6 miles East**

2 WATER WELL OWNER: **Mrs. William (Mary) Nau** Well #1  
 RR#, St. Address, Box # :  
 City, State, ZIP Code : **Spearville, Kansas 67876**  
 Board of Agriculture, Division of Water Resources  
 Application Number:

3 LOCATE WELL'S LOCATION WITH AN "X" IN SECTION BOX:

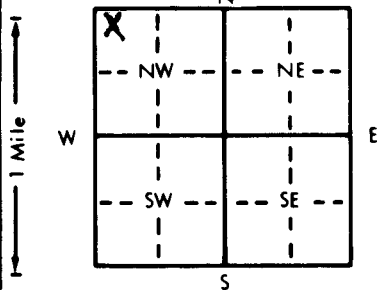

4 DEPTH OF COMPLETED WELL..... ft. ELEVATION:..... ft.  
 Depth(s) Groundwater Encountered 1..... ft. 2..... ft. 3..... ft.  
 WELL'S STATIC WATER LEVEL..... ft. below land surface measured on mo/day/yr  
 Pump test data: Well water was..... ft. after..... hours pumping..... gpm  
 Est. Yield..... gpm: Well water was..... ft. after..... hours pumping..... gpm  
 Bore Hole Diameter..... in. to..... ft., and..... in. to..... ft.  
 WELL WATER TO BE USED AS: 5 Public water supply 8 Air conditioning 11 Injection well  
 1 Domestic 3 Feedlot 6 Oil field water supply 9 Dewatering 12 Other (Specify below)  
 2 Irrigation 4 Industrial 7 Lawn and garden only 10 Monitoring well  
 Was a chemical/bacteriological sample submitted to Department? Yes.....No.....; If yes, mo/day/yr sample was submitted  
 Water Well Disinfected? Yes No

5 TYPE OF BLANK CASING USED: 5 Wrought iron 8 Concrete tile CASING JOINTS: Glued.....Clamped.....  
 1 Steel 3 RMP (SR) 6 Asbestos-Cement 9 Other (specify below) Welded.....  
 2 PVC 4 ABS 7 Fiberglass Threaded.....

Blank casing diameter.....6.....in. to.....110.....ft., Dia.....in. to.....ft., Dia.....in. to.....ft.  
 Casing height above land surface.....in., weight.....lbs./ft. Wall thickness or gauge No.....

TYPE OF SCREEN OR PERFORATION MATERIAL: 7 PVC 10 Asbestos-cement  
 1 Steel 3 Stainless steel 5 Fiberglass 8 RMP (SR) 11 Other (specify).....  
 2 Brass 4 Galvanized steel 6 Concrete tile 9 ABS 12 None used (open hole)

SCREEN OR PERFORATION OPENINGS ARE: 5 Gauzed wrapped 8 Saw cut 11 None (open hole)  
 1 Continuous slot 3 Mill slot 6 Wire wrapped 9 Drilled holes  
 2 Louvered shutter 4 Key punched 7 Torch cut 10 Other (specify).....

SCREEN-PERFORATED INTERVALS: From.....ft. to.....ft., From.....ft. to.....ft.  
 GRAVEL PACK INTERVALS: From.....ft. to.....ft., From.....ft. to.....ft.  
 From.....ft. to.....ft., From.....ft. to.....ft.

6 GROUT MATERIAL: 1 Neat cement 2 Cement grout 3 Bentonite 4 Other.....  
 Grout Intervals: From.....ft. to.....ft., From.....ft. to.....ft., From.....ft. to.....ft.

What is the nearest source of possible contamination:  
 1 Septic tank 4 Lateral lines 7 Pit privy 10 Livestock pens 14 Abandoned water well  
 2 Sewer lines 5 Cess pool 8 Sewage lagoon 11 Fuel storage 15 Oil well/Gas well  
 3 Watertight sewer lines 6 Seepage pit 9 Feedyard 12 Fertilizer storage 16 Other (specify below)  
 13 Insecticide storage

Direction from well? How many feet?

FROM	TO	LITHOLOGIC LOG	FROM	TO	PLUGGING INTERVALS
0	10	Sand & bentonite (mixed)			
10	70	Fill Sand			
70	90	Sand & bentonite			
90	110	Fill sand			

7 CONTRACTOR'S OR LANDOWNER'S CERTIFICATION: This water well was (1) constructed, (2) reconstructed, or (3) plugged under my jurisdiction and was completed on (mo/day/year).....7-17-90..... and this record is true to the best of my knowledge and belief. Kansas Water Well Contractor's License No. ...1.79..... This Water Well Record was completed on (mo/day/yr).....7-31-90..... under the business name of **Joe's Well Service, Inc. Cimarron, Ks.** by (signature) *Joe's Well Service*