

CORRECTION(S) TO WATER WELL RECORD (WWC-5)

(to rectify lacking or incorrect information)

County: Ford

Location listed as:

Section-Township-Range: 25-26-23E

Fraction (  $\frac{1}{4}$   $\frac{1}{4}$   $\frac{1}{4}$ ): NE NW NE

Location changed to:

25-26-23W

NE NW NE

Other changes: Initial statements: \_\_\_\_\_

Changed to: \_\_\_\_\_

Comments: E changed to W

verification method: County maps, location and address information

initials: MJ date: 3-3-06


WATER WELL RECORD Form WWC-5 KSA 82a-1212

1 LOCATION OF WATER WELL: Fraction Section Number Township Number Range Number  
 COUNTY: FORD NE 1/4 NW 1/4 NE 1/4 25 T 26 S R 23 E

Distance and direction from nearest town or city street address of well if located within city?  
 FROM WRIGHT JEWELL 5 EAST, 1 S ON 123 - 1/2 EAST TO KETTLE

2 WATER WELL OWNER: ZURBUCHEN, ALICE Board of Agriculture, Division of Water Resources  
 RR#, St. Address, Box #: 12357 KETTLE ROAD Application Number:  
 City, State, ZIP code: SPEARVILLE, KS 67876-

3 LOCATE WELL'S LOCATION WITH AN "X" IN SECTION BOX:

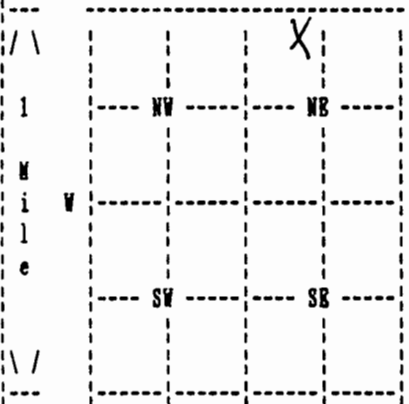

4 DEPTH OF COMPLETED WELL 316 ELEVATION: 0  
 Depth(s) Groundwater Encountered 1. 0 ft. 2. 0 ft. 3. 0 ft.

WELL'S STATIC WATER LEVEL 115 ft. below land surface measured on no/day/yr 10/26/05  
 Pump test data: Well water was 0 ft. after 0 hours pumping 0 gpm

Estimated Yield 50 gpm: Well water was 0 ft. after 0 hours pumping 0 gpm

Bore Hole Diameter 9 in. to 316 ft., and in. to 0 ft.

WELL WATER TO BE USED AS: DOMESTIC

Was a chemical/bacteriological sample submitted to department? No ;  
 If yes, no/day/yr sample was submitted Water well disinfected? Yes

5 TYPE OF BLANK CASING USED: PVC CASING JOINTS: CERTA-LOC  
 Blank casing diameter 5 in. to 316 ft., Dia in. to 0 ft., Dia in. to 0 ft.  
 Casing height above land surface 12 in., weight 200 lbs/ft. Wall thickness or gauge No. 21  
 TYPE OF SCREEN OR PERFORATION MATERIAL: PVC  
 SCREEN OR PERFORATION OPENINGS ARE: SAW CUT

SCREEN PERFORATED INTERVALS: From 210 ft. to 250 ft., From 0 ft. to 0 ft.  
 From 272 ft. to 312 ft., From 0 ft. to 0 ft.  
 GRAVEL PACK INTERVALS: From 75 ft. to 316 ft., From 0 ft. to 0 ft.  
 From 0 ft. to 0 ft., From 0 ft. to 0 ft.

6 GROUT MATERIAL BENTONITE  
 Grout Intervals: From 5 ft. to 75 ft., From 0 ft. to 0 ft., From 0 ft. to 0 ft.  
 What is the nearest source of possible contamination: NONE  
 Direction from well? How many feet? 0

FROM	TO	LITHOLOGIC LOG	FROM	TO	PLUGGING INTERVALS
0	20	01 TOPSOIL 05 CLAY 35 CALACHIE			
20	40	35 CALACHIE 24 THINROCLAYER 32 TAN CLAY			
40	75	32 TAN CLAY 24 THINROCLAYER 08 ROCK LAYERS			
75	76	08 ROCK LAYERS			
76	80	16 GRAY CLAY 07 BLUE SHALE			
80	100	07 BLUE SHALE			
100	120	07 BLUE SHALE 16 GRAY CLAY			
120	160	16 GRAY CLAY 29 SANDSTONE 19 LAYERS			
160	200	16 GRAY CLAY 29 SANDSTONE			
200	316	29 SANDSTONE			

7 CONTRACTOR'S OR LANDOWNER'S CERTIFICATION: This water well was Constructed under my jurisdiction and was completed on (no/day/year) 10/27/05 and this record is true to the best of my knowledge and belief. Kansas Water Well Contractor's License No. 179 This Water Well Record was completed on (no/day/yr) 11/28/05 under the business name of JOB'S WELL SERVICE, INC. by (signature) *Justin Crick*

(Continued)

WATER WELL RECORD Form WWC-5 KSA 82a-1212

1 LOCATION OF WATER WELL:	Fraction	Section Number	Township Number	Range Number
COUNTY: FORD	NE 1/4 NW 1/4 NE 1/4	25	T 26 S	R 23 E

2 WATER WELL OWNER:	ZURBUCHEN, ALICE	Board of Agriculture, Division of Water Resources
RR#, St. Address, Box # :	12357 KETTLE ROAD	Application Number:
City, State, ZIP code :	SPEARVILLE, KS 67876-	

FROM	TO	LITHOLOGIC LOG
316	0	27 ROCK

7 CONTRACTOR'S OR LANDOWNER'S CERTIFICATION: This water well was Constructed under my jurisdiction and was completed on (no/day/year) 10/27/05 and this record is true to the best of my knowledge and belief. Kansas Water Well Contractor's License No. 179 This Water Well Record was completed on (no/day/yr) 11/28/05 under the business name of JOB'S WELL SERVICE, INC. by (signature) *Justin Creek*