

CORRECTION(S) TO WATER WELL RECORD (WWC-5)

(to rectify lacking or incorrect information)

County: Ford

Location listed as:

Section-Township-Range: 2-265-23E

Fraction ($\frac{1}{4}$ $\frac{1}{4}$ $\frac{1}{4}$): NE NW NE

Location changed to:

2-265-23W

NE NW NE

Other changes: Initial statements: _____

Changed to: _____

Comments: _____

verification method: Written & legal descriptions, area road map, and mapping tool on KGS website.

initials: DRF date: 10/2/2007

submitted by: Kansas Geological Survey, Data Resources Library, 1930 Constant Ave., Lawrence, KS 66047-3726

to: Kansas Dept of Health & Environment, Bureau of Water, 1000 SW Jackson, Suite 420, Topeka, KS 66612-1367.


WATER WELL RECORD Form WWC-5 KSA 82a-1212

1 LOCATION OF WATER WELL: Fraction Section Number Township Number Range Number
 COUNTY: FORD NE 1/4 NW 1/4 NE 1/4 2 T 26 S R 23 E

Distance and direction from nearest town or city street address of well if located within city?
 SPEARVILLE - 3 1/2 WEST ON HIGHWAY 50

2 WATER WELL OWNER: BURKE, TOM Board of Agriculture, Division of Water Resources
 RR#, St. Address, Box #: BOX 113 Application Number:
 City, State, ZIP code: SPEARVILLE, KS 67876-

3 LOCATE WELL'S LOCATION WITH AN "X" IN SECTION BOX:

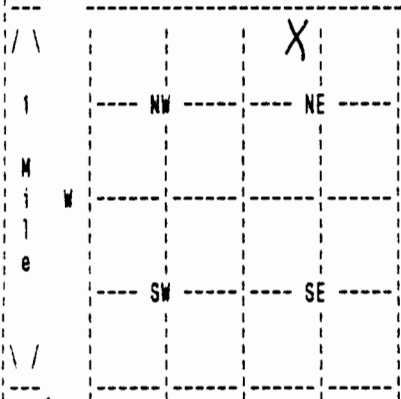

4 DEPTH OF COMPLETED WELL 395 ELEVATION: 0
 Depth(s) Groundwater Encountered 1. 0 ft. 2. 0 ft. 3. 0 ft.

WELL'S STATIC WATER LEVEL 96 ft. below land surface measured on mo/day/yr 05/02/07
 Pump test data: Well water was 0 ft. after 0 hours pumping 0 gpm

Estimated Yield 50 gpm: Well water was 0 ft. after 0 hours pumping 0 gpm

Bore Hole Diameter 9 in. to 395 ft., and in. to 0 ft.

WELL WATER TO BE USED AS: DOMESTIC

Was a chemical/bacteriological sample submitted to department? No ;
 If yes, mo/day/yr sample was submitted Water well disinfected? Yes

5 TYPE OF BLANK CASING USED: CERTA LOC CASIN CASING JOINTS: CERTA-LOC
 Blank casing diameter 5 in. to 395 ft., Dia in. to 0 ft., Dia in. to 0 ft.
 Casing height above land surface 12 in., weight 200 lbs/ft. Wall thickness or gauge No. 21 17
 TYPE OF SCREEN OR PERFORATION MATERIAL: PVC
 SCREEN OR PERFORATION OPENINGS ARE: SAW CUT

SCREEN PERFORATED INTERVALS: From 310 ft. to 395 ft., From 0 ft. to 0 ft.
 From 0 ft. to 0 ft., From 0 ft. to 0 ft.
 GRAVEL PACK INTERVALS: From 26 ft. to 395 ft., From 0 ft. to 0 ft.
 From 0 ft. to 0 ft., From 0 ft. to 0 ft.

6 GROUT MATERIAL BENTONITE
 Grout Intervals: From 5 ft. to 26 ft., From 0 ft. to 0 ft., From 0 ft. to 0 ft.
 What is the nearest source of possible contamination: NONE
 Direction from well? How many feet? 0

FROM	TO	LITHOLOGIC LOG	FROM	TO	PLUGGING INTERVALS
0	20	01 TOPSOIL 32 TAN CLAY			
20	40	32 TAN CLAY 02 FINE SAND 39 SAND ROCK			
40	60	39 SAND ROCK 32 TAN CLAY			
60	100	16 GRAY CLAY 32 TAN CLAY			
100	120	16 GRAY CLAY			
120	140	16 GRAY CLAY 40 TAN SANDSTON			
140	160	40 TAN SANDSTON			
160	220	16 GRAY CLAY			
220	240	16 GRAY CLAY 29 SANDSTONE 19 LAYERS			
240	310	29 SANDSTONE			

7 CONTRACTOR'S OR LANDOWNER'S CERTIFICATION: This water well was Constructed under my jurisdiction and was completed on (mo/day/year) 05/03/07 and this record is true to the best of my knowledge and belief. Kansas Water Well Contractor's License No. 179 This Water Well Record was completed on (mo/day/yr) 05/08/07 under the business name of JOE'S WELL SERVICE, INC. by (signature) *Julid Crick*

(Continued)

WATER WELL RECORD Form WWC-5 KSA 82a-1212

1 LOCATION OF WATER WELL: Fraction Section Number Township Number Range Number
COUNTY: FORD NE 1/4 NW 1/4 NE 1/4 2 T 26 S R 23 E

2 WATER WELL OWNER: BURKE, TOM
RR#, St. Address, Box #: BOX 113 Board of Agriculture, Division of Water Resources
City, State, ZIP code : SPEARVILLE, KS 67876- Application Number:

FROM	TO	LITHOLOGIC LOG
310	360	29 SANDSTONE 16 GRAY CLAY
360	390	29 SANDSTONE
390	400	07 BLUE SHALE

7 CONTRACTOR'S OR LANDOWNER'S CERTIFICATION: This water well was Constructed under my jurisdiction and was completed on (mo/day/year) 05/03/07 and this record is true to the best of my knowledge and belief. Kansas Water Well Contractor's License No. 179 This Water Well Record was completed on (mo/day/yr) 05/08/07 under the business name of JOE'S WELL SERVICE, INC. by (signature) *Justin Creek*