

WATER WELL RECORD

Form WWC-5


Division of Water Resources App. No.

1 LOCATION OF WATER WELL: County: Ford	Fraction NE 1/4 NW 1/4 NW 1/4 SW 1/4	Section Number 25	Township No. T 26 S	Range Number R 23 <input type="checkbox"/> E <input checked="" type="checkbox"/> W
--	---	----------------------	------------------------	---

Street/Rural Address of Well Location; if unknown, distance & direction from nearest town or intersection: If at owner's address, check here
Jewell & Road 123 1/2 Mile N 1/4 Mile E

Global Positioning System (GPS) information:
Latitude: N 37. Deg. 45' 22.137 (in decimal degrees)
Longitude: W 099 Deg 47' 41.334 (in decimal degrees)
Elevation: 2416
Datum: WGS 84, NAD 83, NAD 27
Collection Method:
 GPS unit (Make/Model: Sony Ericsson)
 Digital Map/Photo, Topographic Map, Land Survey
Est. Accuracy: <3 m, 3-5 m, 5-15 m, >15 m

2 WATER WELL OWNER: Matt Nau
RR#, Street Address, Box #: 520 S. Main St.
City, State, ZIP Code : Offerle, KS 67563

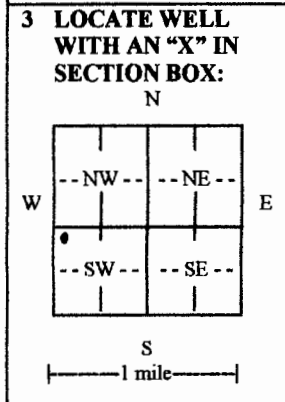

4 DEPTH OF COMPLETED WELL 335 ft.

Depth(s) Groundwater Encountered (1)..... ft. (2)..... ft. (3)..... ft.
WELL'S STATIC WATER LEVEL. 139 ft. below land surface measured on mo/day/yr.....
Pump test data: Well water was..... ft. after..... hours pumping..... gpm
EST. YIELD. 50 gpm. Well water was..... ft. after..... hours pumping..... gpm
Bore Hole Diameter 10 in. to..... ft., and..... in. to..... ft.
WELL WATER TO BE USED AS: Public water supply Geothermal Injection well
 Domestic Feedlot Oil field water supply Dewatering Other (Specify below)
 Irrigation Industrial Domestic-lawn & garden Monitoring well
Was a chemical/bacteriological sample submitted to Department? Yes No
If yes, mo/day/yr sample was submitted.....
Water well disinfected? Yes No

5 TYPE OF CASING USED: Steel PVC Other.....
CASING JOINTS: Glued Clamped Welded Threaded
Casing diameter 5 in. to..... ft., Diameter..... in. to..... ft., Diameter..... in. to..... ft.
Casing height above land surface 12 in., Weight..... lbs./ft., Wall thickness or gauge No.
TYPE OF SCREEN OR PERFORATION MATERIAL:
 Steel Stainless Steel PVC Other (Specify).....
 Brass Galvanized Steel None used (open hole)
SCREEN OR PERFORATION OPENINGS ARE:
 Continuous slot Mill slot Gauze wrapped Torch cut Drilled holes None (open hole)
 Louvered shutter Key punched Wire wrapped Saw cut Other (specify).....
SCREEN-PERFORATED INTERVALS: From 200 ft. to 330 ft., From..... ft. to..... ft.
GRAVEL PACK INTERVALS: From..... ft. to..... ft., From..... ft. to..... ft.

6 GROUT MATERIAL: Neat cement Cement grout Bentonite Other.....
Grout Intervals: From 6 ft. to 30 ft., From..... ft. to..... ft., From..... ft. to..... ft.
What is the nearest source of possible contamination:
 Septic tank Lateral lines Pit privy Livestock pens Insecticide storage Other (specify below)
 Sewer lines Cesspool Sewage lagoon Fuel storage Abandoned water well
 Watertight sewer lines Seepage pit Feedyard Fertilizer storage Oil well/gas well **NONE**
Direction from well..... Distance from well.....

FROM	TO	LITHOLOGIC LOG	FROM	TO	LITHO. LOG (cont.) or PLUGGING INTERVALS
0	20	Top Soil, Tan Clay	145	155	Gray Sandstone
20	40	Tan Clay, Limestone Layers	155	180	Blue Shale
40	60	Tan Clay, Fine Sand, Limestone Laye	180	200	Blue Shale, Gray Clay
60	70	Medium Sand	200	280	Grav Clay w/Gray Sandstone Layers
70	72	Rock	280	310	Tan Sandstone
72	80	Blue Clay	310	312	Rock
80	100	Blue Clay	312	320	Gray Sandstone
100	110	Blue Clay	320	340	Grav Sandstone
110	120	Shale	340	360	Gray Clay
120	145	Gray Clay			

7 CONTRACTOR'S OR LANDOWNER'S CERTIFICATION: This water well was constructed, reconstructed, or plugged under my jurisdiction and was completed on (mo/day/year) 10-11-2012 and this record is true to the best of my knowledge and belief.
Kansas Water Well Contractor's License No. 846 This Water Well Record was completed on (mo/day/year) 10/29/2012 under the business name of Nash Water Well Service, LLC by (signature) *Nash Water Well Service*

INSTRUCTIONS: Use typewriter or ball point pen. PLEASE PRESS FIRMLY and PRINT clearly. Please fill in blanks and check the correct answers. Send three copies (white, blue, pink) to Kansas Department of Health and Environment, Bureau of Water, Geology Section, 1000 SW Jackson St., Suite 420, Topeka, Kansas 66612-1367. Telephone 785-296-5524. Send one copy to WATER WELL OWNER and retain one for your records. Include fee of \$5.00 for each constructed well. Visit us at <http://www.kdheks.gov/waterwell/index.html>.