


26 24

1 LOCATION OF WATER WELL: Fraction NW 1/4 NW 1/4 SE 1/4 Section Number 31 Township Number T S Range Number R W
 COUNTY: FORD

Distance and direction from nearest town or city street address of well if located within city?
120 MCCOUSTLAND ROAD #2 DODGE CITY, KS 67801-

2 WATER WELL OWNER: SMITH, CHAD
 RR#, St. Address, Box #: 120 MCCOUSTLAND ROAD #2 Board of Agriculture, Division of Water Resources
 City, State, ZIP code: DODGE CITY, KS 67801- Application Number:

3 LOCATE WELL'S LOCATION WITH AN "X" IN SECTION BOX: 4 DEPTH OF COMPLETED WELL 165 ELEVATION: 0
 Depth(s) Groundwater Encountered 1. 0 ft. 2. 0 ft. 3. 0 ft.

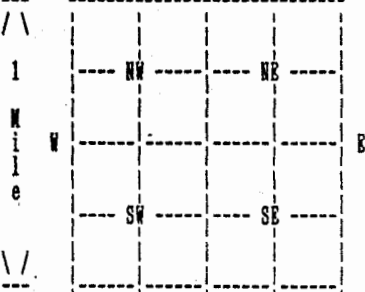

WELL'S STATIC WATER LEVEL 35 ft. below land surface measured on no/day/yr 10/17/95
 Pump test data: Well water was 0 ft. after 0 hours pumping 0 gpm
 Estimated Yield 75 gpm: Well water was 0 ft. after 0 hours pumping 0 gpm
 Bore Hole Diameter 9 in. to 165 ft., and in. to 0 ft.
 WELL WATER TO BE USED AS: DOMESTIC
 Was a chemical/bacteriological sample submitted to department? No ;
 If yes, no/day/yr sample was submitted Water well disinfected? Yes

5 TYPE OF BLANK CASING USED: PVC CASING JOINTS: GLUED
 Blank casing diameter 5 in. to 165 ft., Dia in. to 0 ft., Dia in. to 0 ft.
 Casing height above land surface 12 in., weight 200 lbs/ft. Wall thickness or gauge No. 21
 TYPE OF SCREEN OR PERFORATION MATERIAL: PVC
 SCREEN OR PERFORATION OPENINGS ARE: SAW CUT

SCREEN PERFORATED INTERVALS: From 130 ft. to 160 ft., From 0 ft. to 0 ft.
 From 0 ft. to 0 ft., From 0 ft. to 0 ft.
 GRAVEL PACK INTERVALS: From 40 ft. to 165 ft., From 0 ft. to 0 ft.
 From 0 ft. to 0 ft., From 0 ft. to 0 ft.

6 GROUT MATERIAL BENTONITE
 Grout Intervals: From 0 ft. to 40 ft., From 0 ft. to 0 ft., From 0 ft. to 0 ft.
 What is the nearest source of possible contamination: LAWN WELL
 Direction from well? EAST How many feet? 60

FROM	TO	LITHOLOGIC LOG	FROM	TO	PLUGGING INTERVALS
0	20	TOPSOIL SAND COARSE SAND			
20	100	CLAY SAND IN LAYERS			
100	160	COARSE SAND GRAVEL			
160	165	YELLOW CLAY BLUE SHALE			

7 CONTRACTOR'S OR LANDOWNER'S CERTIFICATION: This water well was Constructed under my jurisdiction and was completed on (no/day/year) 10/18/95 and this record is true to the best of my knowledge and belief. Kansas Water Well Contractor's License No. 179 This Water Well Record was completed on (no/day/yr) 10/31/95 under the business name of JOB'S WELL SERVICE, INC. by (signature) Josiah Creek