


1 LOCATION OF WATER WELL: Fraction $\frac{1}{4}$ S $1\frac{1}{2}$ $\frac{1}{4}$ SW $\frac{1}{4}$ Section Number 20 Township Number T 26 S Range Number R 24 EW

Distance and direction from nearest town or city street address of well if located within city?
2 Miles North of Dodge City

2 WATER WELL OWNER: Ford County Landfill
RR#, St. Address, Box #: Jetmore Star Route Board of Agriculture, Division of Water Resources
City, State, ZIP Code: Dodge City, Ks. 67801 MW12D Application Number:

3 LOCATE WELL'S LOCATION WITH AN "X" IN SECTION BOX:

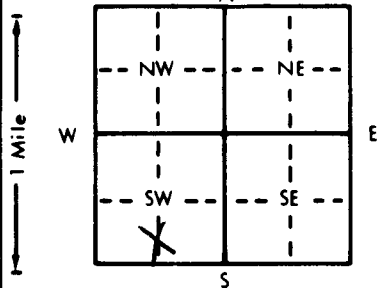

4 DEPTH OF COMPLETED WELL: 201 ft. ELEVATION:

Depth(s) Groundwater Encountered 1. ft. 2. ft. 3. ft.
WELL'S STATIC WATER LEVEL .109.33 ft. below land surface measured on mo/day/yr
Pump test data: Well water was ft. after hours pumping gpm
Est. Yield gpm: Well water was ft. after hours pumping gpm
Bore Hole Diameter .8 in. to .201 ft., and in. to ft.
WELL WATER TO BE USED AS: 5 Public water supply 8 Air conditioning 11 Injection well
1 Domestic 3 Feedlot 6 Oil field water supply 9 Dewatering 12 Other (Specify below)
2 Irrigation 4 Industrial 7 Lawn and garden only 10 Monitoring well
Was a chemical/bacteriological sample submitted to Department? Yes. No. X; If yes, mo/day/yr sample was submitted
Water Well Disinfected? Yes No X

5 TYPE OF BLANK CASING USED: 5 Wrought iron 8 Concrete tile CASING JOINTS: Glued Clamped

1 Steel 3 RMP (SR) 6 Asbestos-Cement 9 Other (specify below) Welded
2 PVC 4 ABS 7 Fiberglass Threaded. X
Blank casing diameter .4 in. to .181 ft., Dia in. to ft., Dia in. to ft.
Casing height above land surface .30 in., weight 2.071 lbs./ft. Wall thickness or gauge No. .237

TYPE OF SCREEN OR PERFORATION MATERIAL: 7 PVC 10 Asbestos-cement
1 Steel 3 Stainless steel 5 Fiberglass 8 RMP (SR) 11 Other (specify)
2 Brass 4 Galvanized steel 6 Concrete tile 9 ABS 12 None used (open hole)

SCREEN OR PERFORATION OPENINGS ARE: 5 Gauzed wrapped 8 Saw cut 11 None (open hole)
1 Continuous slot 3 Mill slot 6 Wire wrapped 9 Drilled holes
2 Louvered shutter 4 Key punched 7 Torch cut 10 Other (specify)

SCREEN-PERFORATED INTERVALS: From .181 ft. to .201 ft., From ft. to ft.
From ft. to ft., From ft. to ft.
GRAVEL PACK INTERVALS: From .175 ft. to .201 ft., From ft. to ft.
From ft. to ft., From ft. to ft.

6 GROUT MATERIAL: 1 Neat cement 2 Cement grout 3 Bentonite 4 Other
Grout Intervals: From .0 ft. to .169 ft., From .169 ft. to .175 ft., From ft. to ft.

What is the nearest source of possible contamination:
1 Septic tank 4 Lateral lines 7 Pit privy 10 Livestock pens 14 Abandoned water well
2 Sewer lines 5 Cess pool 8 Sewage lagoon 11 Fuel storage 15 Oil well/Gas well
3 Watertight sewer lines 6 Seepage pit 9 Feedyard 12 Fertilizer storage 16 Other (specify below)
Landfill

Direction from well? How many feet?

FROM	TO	LITHOLOGIC LOG	FROM	TO	PLUGGING INTERVALS
0	2	Surface			
2	16	Loess			
16	38	Clay & Caliche			
38	46	Cemented Sand, Caliche & Clay			
46	60	Cemented Sand			
60	120	Sandy Clay w/a Few Cemented & Med. Sand Strks.			
120	133	Fine Sugar Sand			
133	137	Sandy Clay			
137	142	Fine Sand			
142	150	Sandy Clay			
150	160	Fine Sand			
160	185	Med. Sand & Gravel w/a few Clay Layers			
185	201	Semi-Tight Med. Sand w/Clay Strks.			

7 CONTRACTOR'S OR LANDOWNER'S CERTIFICATION: This water well was (1) constructed, (2) reconstructed, or (3) plugged under my jurisdiction and was completed on (mo/day/year) .10-1-96 and this record is true to the best of my knowledge and belief. Kansas Water Well Contractor's License No. 554 This Water Well Record was completed on (mo/day/yr)10-11-96 under the business name of Woofter Pump & Well, Inc. by (signature) July C. Woofter