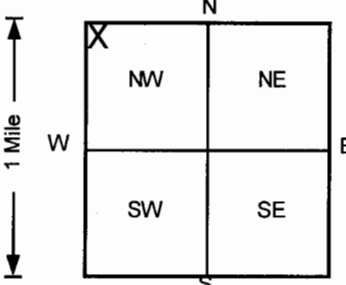


1 LOCATION OF WATER WELL:		Fraction		Section Number	Township Number	Range Number
County: Ford		NW ¼ NW ¼ NW ¼		31	T 26 S	R 24 E
Distance and direction from nearest town or city street address of well if located within city? 2504 E. Trail Street, Dodge City, Kansas						
2 WATER WELL OWNER: Isaac Trucking, Inc.						
RR#, St. Address, Box # : Box 1317				Board of Agriculture, Division of Water Resources		
City, State, ZIP Code : Dodge City, Kansas 67801				Application Number:		
3 LOCATE WELL'S LOCATION WITH AN "X" IN SECTION BOX:		4 DEPTH OF COMPLETED WELL: 35 ft. ELEVATION: 2481.59				
		Depth(s) Groundwater Encountered 1. 999 ft. 2. 999 ft. 3. 999 ft.				
		WELL'S STATIC WATER LEVEL 27.99 ft. below land surface measured on mo/day/yr 3/27/97				
		Pump test data: Well water was NA ft. after NA hours pumping NA gpm				
		Est. Yield NA gpm: Well water was NA ft. after NA hours pumping NA gpm				
		Bore Hole Diameter 8 in. to 35 ft. and 35 in. to 35 ft.				
		WELL WATER TO BE USED AS: 5 Public water supply 8 Air conditioning 11 Injection well				
		1 Domestic 3 Feedlot 6 Oil field water supply 9 Dewatering 12 Other (Specify below)				
		2 Irrigation 4 Industrial 7 Lawn and garden only 10 Monitoring well				
		Was a chemical/bacteriological sample submitted to Department? Yes NA No NA ; If yes, mo/day/yr sample was submitted				
		Water Well Disinfected? Yes NA No NA				
5 TYPE OF BLANK CASING USED:						
1 Steel 3 RMP (SR) 5 Wrought iron 8 Concrete tile CASING JOINTS: Glued NA Clamped NA						
2 PVC 4 ABS 6 Asbestos-Cement 9 Other (specify below) Welded NA						
Casing height above land surface -2.52 in., weight NA lbs./ft. Wall thickness or gauge No. SCH 40						
TYPE OF SCREEN OR PERFORATION MATERIAL						
1 Steel 3 Stainless steel 5 Fiberglass 7 PVC 10 Asbestos-cement						
2 Brass 4 Galvanized steel 6 Concrete tile 8 RMP (SR) 11 Other (specify)						
SCREEN OR PERFORATION OPENINGS ARE:						
1 Continuous slot 3 Mill slot 5 Gauzed wrapped 8 Saw cut 11 None (open hole)						
2 Louvered shutter 4 Key punched 6 Wire wrapped 9 Drilled holes						
3 Torch cut 10 Other (specify)						
SCREEN-PERFORATED INTERVALS: From 20 ft. to 35 ft. From 20 ft. to 35 ft. From 20 ft. to 35 ft. From 20 ft. to 35 ft.						
GRAVEL PACK INTERVALS: From 18 ft. to 35 ft. From 18 ft. to 35 ft. From 18 ft. to 35 ft. From 18 ft. to 35 ft.						
6 GROUT MATERIAL: 1 Neat cement 2 Cement grout 3 Bentonite 4 Other						
Grout Intervals: From 0 ft. to 16 ft. From 16 ft. to 18 ft. From 18 ft. to 18 ft. From 18 ft. to 18 ft.						
What is the nearest source of possible contamination:						
1 Septic tank 4 Lateral lines 7 Pit privy 10 Livestock pens 14 Abandoned water well						
2 Sewer lines 5 Cess pool 8 Sewage lagoon 11 Fuel storage 15 Oil well/Gas well						
3 Watertight sewer lines 6 Seepage pit 9 Feedyard 12 Fertilizer storage 16 Other (specify below)						
UST Basin						
Direction from well? East How many feet? 100						
FROM TO LITHOLOGIC LOG FROM TO PLUGGING INTERVALS						
0 1 Gravel,						
1 6 Sand, Brown						
6 21 Clay, Brown						
21 35 Sand, Brown						
MW1, Tag # 00180654, Flushmount						
Project Name: Isaac Truckline, Inc.						
GeoCore # 453, KDHE # U1 029 032						
7 CONTRACTOR'S OR LANDOWNER'S CERTIFICATION: This water well was (1) constructed, (2) reconstructed, or (3) plugged under my jurisdiction and was completed on (mo/day/year) 3/18/97 and this record is true to the best of my knowledge and belief.						
Kansas Water Well Contractor's License No. 527 This Water Well Record was completed on (mo/day/yr) 4/7/97						
under the business name of GeoCore Services, Inc. by (signature) Bob Roll						
INSTRUCTIONS: Use typewriter or ball point pen. PLEASE PRESS FIRMLY and PRINT clearly. Please fill in blanks, underline or circle the correct answers. Send top three copies to Kansas Department of Health and Environment, Bureau of Water, Topeka, Kansas 66620-0001. Telephone: 913-296-5545. Send one to WATER WELL OWNER and retain one for your records.						