


1 LOCATION OF WATER WELL: County: Ford	Fraction SW ¼ NE ¼ NE ¼	Section Number 22	Township Number T 26 S	Range Number R 24 EW
--------------------------------------------------	-----------------------------------	-----------------------------	----------------------------------	---------------------------------------

Distance and direction from nearest town or city street address of well if located within city?
Approx. 3 miles E. on Hwy 50, Dodge City, KS

2 WATER WELL OWNER: **Wilson & Company**
 RR#, St. Address, Box # : **P.O. Box 1640**
 City, State, ZIP Code : **Salina, Kansas 67401**
 Board of Agriculture, Division of Water Resources
 Application Number:

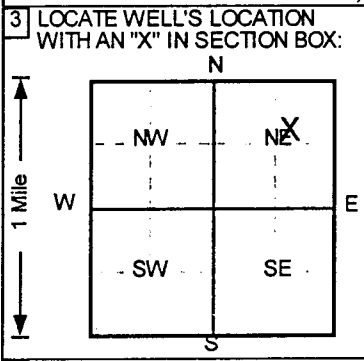

4 DEPTH OF COMPLETED WELL: **114** ft ELEVATION: **999** ft
 Depth(s) Groundwater Encountered 1. **999** ft 2. _____ ft 3. _____ ft
 WELL'S STATIC WATER LEVEL **102.31** ft below land surface measured on mo/day/yr _____
 Pump test data: Well water was **NA** ft after _____ hours pumping _____ gpm
 Est. Yield **NA** gpm: Well water was _____ ft after _____ hours pumping _____ gpm
 Bore Hole Diameter **8** in. to **114** ft, and _____ in. to _____ ft
 WELL WATER TO BE USED AS: 5 Public water supply 8 Air conditioning 11 Injection well
 1 Domestic 3 Feedlot 6 Oil field water supply 9 Dewatering 12 Other (Specify below)
 2 Irrigation 4 Industrial 7 Lawn and garden only **10** Monitoring well _____
 Was a chemical/bacteriological sample submitted to Department? Yes _____ No ; If yes, mo/day/yr sample was submitted
 Water Well Disinfected? Yes _____ No

5 TYPE OF BLANK CASING USED:
 1 Steel 3 RMP (SR) 5 Wrought iron 8 Concrete tile CASING JOINTS: Glued _____ Clamped _____
2 PVC 4 ABS 6 Asbestos-Cement 9 Other (specify below) Welded _____
 7 Fiberglass _____ Threaded
 Blank casing diameter **2** in. to **94** ft, Dia _____ in. to _____ ft, Dia _____ in. to _____ ft
 Casing height above land surface **30** in., weight _____ lbs./ft. Wall thickness or gauge No. **Sch 40**
 TYPE OF SCREEN OR PERFORATION MATERIAL **7** PVC 10 Asbestos-cement
 1 Steel 3 Stainless steel 5 Fiberglass **8** RMP (SR) 11 Other (specify) _____
 2 Brass 4 Galvanized steel 6 Concrete tile 9 ABS 12 None used (open hole)
 SCREEN OR PERFORATION OPENINGS ARE:
 1 Continuous slot **3** Mill slot 5 Gauzed wrapped 8 Saw cut 11 None (open hole)
 2 Louvered shutter 4 Key punched 6 Wire wrapped 9 Drilled holes
 7 Torch cut 10 Other (specify) _____
 SCREEN-PERFORATED INTERVALS: From **94** ft to **114** ft, From _____ ft to _____ ft
 From _____ ft to _____ ft, From _____ ft to _____ ft
 GRAVEL PACK INTERVALS: From **88.5** ft to **114** ft, From _____ ft to _____ ft
 From _____ ft to _____ ft, From _____ ft to _____ ft

6 GROUT MATERIAL: 1 Neat cement **2** Cement grout **3** Bentonite 4 Other _____
 Grout Intervals: From **0** ft to **82** ft, From **82** ft to **88.5** ft, From _____ ft to _____ ft
 What is the nearest source of possible contamination:
 1 Septic tank 4 Lateral lines 7 Pit privy 10 Livestock pens 14 Abandoned water well
 2 Sewer lines 5 Cess pool 8 Sewage lagoon 11 Fuel storage 15 Oil well/Gas well
 3 Watertight sewer lines 6 Seepage pit 9 Feedyard 12 Fertilizer storage **16** Other (specify below)
 _____ **Unknown** _____
 Direction from well? _____ How many feet? _____

FROM	TO	LITHOLOGIC LOG	FROM	TO	PLUGGING INTERVALS
0	2.5	Clay, Dark Brown			
2.5	38	Clay, Brown			
38	40	Clay, Reddish Brown			
40	46.5	Clay, Brown			
46.5	55	Silt, Tan			
55	60	Clay, Pinkish Brown			
60	73	Silt, Reddish Brown			
73	86	Silt, Pinkish Tan			
86	86.5	Clay, Reddish Brown			
86.5	114	Silt, Pinkish Tan			
					CP-1, Tag #, Abovegrade
					Project Name: Wilson Farmland-Dodge
					GeoCore # 425 , Wilson and Company # 93 420 060 01/0

7 CONTRACTOR'S OR LANDOWNER'S CERTIFICATION: This water well was **1** constructed, **2** reconstructed, or **3** plugged under my jurisdiction and was completed on (mo/day/year) **12/6/96** and this record is true to the best of my knowledge and belief.
 Kansas Water Well Contractor's License No. **527** This Water Well Record was completed on (mo/day/yr) **1/2/97**
 under the business name of **GeoCore Services, Inc.** by (signature) *Dale Cochran*

OFFICE USE ONLY
T
R
EW
SEC.
1/4
1/4