


1 LOCATION OF WATER WELL: County: **FORD** Fraction: **NE 1/4 SW 1/4 SE 1/4** Section Number: **13** Township Number: **T 26 S** Range Number: **R 23 24 EW**

Distance and direction from nearest town or city street address of well if located within city? **West of house & yard #48**

2 WATER WELL OWNER: **Merlin Fry (EPA + B&V)**  
 RR#, St. Address, Box #: **P.O. Box 57**  
 City, State, ZIP Code: **Wright, Ks**  
 Board of Agriculture, Division of Water Resources  
 Application Number:

3 LOCATE WELL'S LOCATION WITH AN "X" IN SECTION BOX:

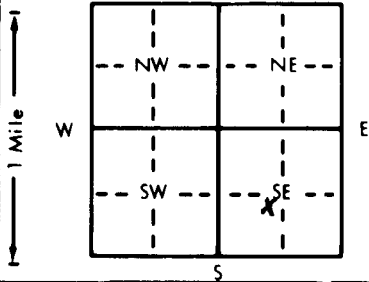

4 DEPTH OF COMPLETED WELL: **120** ft. ELEVATION:  
 Depth(s) Groundwater Encountered 1. . . . . ft. 2. . . . . ft. 3. . . . . ft.  
 WELL'S STATIC WATER LEVEL . . . . . ft. below land surface measured on mo/day/yr  
 Pump test data: Well water was . . . . . ft. after . . . . . hours pumping . . . . . gpm  
 Est. Yield . . . . . gpm: Well water was . . . . . ft. after . . . . . hours pumping . . . . . gpm  
 Bore Hole Diameter: **10** in. to **120** in. to . . . . . in. to . . . . . in.  
 WELL WATER TO BE USED AS: 5 Public water supply 8 Air conditioning 11 Injection well  
 1 Domestic 3 Feedlot 6 Oil field water supply 9 Dewatering 12 Other (Specify below)  
 2 Irrigation 4 Industrial 7 Lawn and garden only 10 Monitoring well  
 Was a chemical/bacteriological sample submitted to Department? Yes . . . . . No  . . . . . If yes, mo/day/yr sample was sub-  
 mitted  
 Water Well Disinfected? Yes . . . . . No

5 TYPE OF BLANK CASING USED:  
 1 Steel  3 RMP (SR)  6 Asbestos-Cement  9 Other (specify below) Welded . . . . .  
 2 PVC  4 ABS  7 Fiberglass . . . . . Threaded . . . . .  
 Blank casing diameter: **5** in. to **80** ft. Dia. . . . . in. to . . . . . ft. Dia. . . . . in. to . . . . . ft.  
 Casing height above land surface: **12** in. weight **sch 40** lbs./ft. Wall thickness or gauge No. . . . .  
 TYPE OF SCREEN OR PERFORATION MATERIAL:  
 1 Steel  3 Stainless steel  5 Fiberglass  7 PVC  10 Asbestos-cement  
 2 Brass  4 Galvanized steel  6 Concrete tile  9 ABS  12 None used (open hole)  
 SCREEN OR PERFORATION OPENINGS ARE:  
 1 Continuous slot  3 Mill slot  5 Gauzed wrapped  8 Saw cut  11 None (open hole)  
 2 Louvered shutter  4 Key punched  6 Wire wrapped  9 Drilled holes  
 7 Torch cut  10 Other (specify) . . . . .  
 SCREEN-PERFORATED INTERVALS: From **80** ft. to **120** ft. From . . . . . ft. to . . . . . ft.  
 GRAVEL PACK INTERVALS: From **57** ft. to **120** ft. From . . . . . ft. to . . . . . ft.  
 From . . . . . ft. to . . . . . ft. From . . . . . ft. to . . . . . ft.

6 GROUT MATERIAL: 1 Neat cement 2 Cement grout  3 Bentonite 4 Other **fly ash**  
 Grout Intervals: From . . . . . ft. to . . . . . ft., From **0** ft. to **50** ft., From **50** ft. to **57** ft.  
 What is the nearest source of possible contamination:  
 1 Septic tank  4 Lateral lines  7 Pit privy  10 Livestock pens  14 Abandoned water well  
 2 Sewer lines  5 Cess pool  8 Sewage lagoon  11 Fuel storage  15 Oil well/Gas well  
 3 Watertight sewer lines  6 Seepage pit  9 Feedyard  12 Fertilizer storage  16 Other (specify below)  
 13 Insecticide storage  
 Direction from well? **east?** How many feet? **<50'**

FROM	TO	LITHOLOGIC LOG	FROM	TO	PLUGGING INTERVALS
0	57	Brn silty clay			
57	65	Sandy clay w/ calciche			
65	72	Calciche			
72	74	Sandy clay			
74	79	Cemented sand w/ clay			
79	87	White sandy clay			
87	91	Clay w/ cement sand			
91	108	Coarse sand w/ brn clay			
108	124	Red + lt. gray shaley clay			

7 CONTRACTOR'S OR LANDOWNER'S CERTIFICATION: This water well was  (1) constructed, (2) reconstructed, or (3) plugged under my jurisdiction and was completed on (mo/day/year) **9-17-97** and this record is true to the best of my knowledge and belief. Kansas Water Well Contractor's License No. **581** This Water Well Record was completed on (mo/day/yr) **9/18/97** under the business name of **Layne Western Co** by (signature) **Steven R Mitchell**