

Hoiz # 67


1 LOCATION OF WATER WELL: County: <b>Ford</b>	Fraction <b>SE 1/4 SW 1/4 NW 1/4</b>	Section Number <b>23</b>	Township Number <b>T 26 S</b>	Range Number <b>R 24 E (W)</b>
--	---	-----------------------------	----------------------------------	-----------------------------------

Distance and direction from nearest town or city street address of well if located within city?  
**1.5 miles west of Wright, Kansas**

2 WATER WELL OWNER: **Farmland Industries**  
 RR#, St. Address, Box #: **HyWay 50 E**  
 City, State, ZIP Code: **Dodge City, Kansas 67801**

Board of Agriculture, Division of Water Resources  
 Application Number:

3 LOCATE WELL'S LOCATION WITH AN "X" IN SECTION BOX:

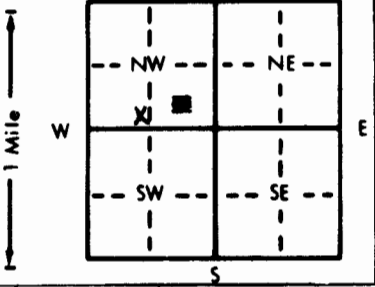

4 DEPTH OF COMPLETED WELL: **130** ft. ELEVATION: **slope**

Depth(s) Groundwater Encountered 1. **40** ft. 2. ft. 3. ft.

WELL'S STATIC WATER LEVEL **35** ft. below land surface measured on mo/day/yr **2-8-84**

Pump test data: Well water was ft. after hours pumping gpm

Est. Yield gpm: Well water was ft. after hours pumping gpm

Bore Hole Diameter **9 3/4** in. to **130** ft., and in. to ft.

WELL WATER TO BE USED AS:

5 Public water supply	8 Air conditioning	11 Injection well
1 Domestic	3 Feedlot	6 Oil field water supply
2 Irrigation	4 Industrial	7 Lawn and garden only
		10 <u>Observation well</u>

12 Other (Specify below)

Was a chemical/bacteriological sample submitted to Department? Yes.....No.....**X**.....; If yes, mo/day/yr sample was submitted

Water Well Disinfected? Yes No **X**

5 TYPE OF BLANK CASING USED:

1 Steel	3 RMP (SR)	5 Wrought iron	8 Concrete tile	CASING JOINTS: Glued <b>X</b> Clamped
<del>2 PVC</del>	4 ABS	6 Asbestos-Cement	9 Other (specify below)	Welded
		7 Fiberglass		Threaded

Blank casing diameter **5** in. to **130** ft., Dia. in. to ft., Dia. in. to ft.

Casing height above land surface **12** in., weight **3** lbs./ft. Wall thickness or gauge No. **SDR 21**

TYPE OF SCREEN OR PERFORATION MATERIAL:

1 Steel	3 Stainless steel	5 Fiberglass	8 RMP (SR)	11 Other (specify)
2 Brass	4 Galvanized steel	6 Concrete tile	9 ABS	12 None used (open hole)

SCREEN OR PERFORATION OPENINGS ARE:

1 Continuous slot	3 Mill slot	5 Gauzed wrapped	8 <u>Saw cut</u>	11 None (open hole)
2 Louvered shutter	4 Key punched	6 Wire wrapped	9 Drilled holes	
		7 Torch cut	10 Other (specify)	

SCREEN-PERFORATED INTERVALS: From **90** ft. to **130** ft., From ft. to ft.

GRAVEL PACK INTERVALS: From **13** ft. to **130** ft., From ft. to ft.

6 GROUT MATERIAL: 1 Neat cement 2 Cement grout 3 Bentonite 4 Other

Grout Intervals: From **3** ft. to **13** ft., From ft. to ft., From ft. to ft.

What is the nearest source of possible contamination:

1 Septic tank	4 Lateral lines	7 Pit privy	10 Livestock pens	14 Abandoned water well
2 Sewer lines	5 Cess pool	8 Sewage lagoon	11 Fuel storage	15 Oil well/Gas well
3 Watertight sewer lines	6 Seepage pit	9 Feedyard	12 Fertilizer storage	16 Other (specify below)
			13 Insecticide storage	<b>none</b>

Direction from well? How many feet?

FROM	TO	LITHOLOGIC LOG	FROM	TO	LITHOLOGIC LOG
0	3	Surface			
3	25	Brown clay			
25	40	Green clay with white rock			
40	45	Medium sand 20% clay			
45	46	Layer of hard rock			
46	68	Brown and caleche clay			
68	77	Brown yellow clay 20% grit			
77	94	Fine sand with 10% clay			
94	98	Brown clay			
98	122	Fine sand			
122	128	Brown clay			
128	130	Red and yellow clay 10% sand			
130	135	Yellow clay			

7 CONTRACTOR'S OR LANDOWNER'S CERTIFICATION: This water well was (1) constructed, (2) reconstructed, or (3) plugged under my jurisdiction and was completed on (mo/day/year) **2-9-84** and this record is true to the best of my knowledge and belief. Kansas

Water Well Contractor's License No. **302** This Water Well Record was completed on (mo/day/yr) **5-10-87**

under the business name of **Hodde Drilling Co.** by (signature) *Willie Hodde*

INSTRUCTIONS: Use typewriter or ball point pen. PLEASE PRESS FIRMLY and PRINT clearly. Please fill in blanks, underline or circle the correct answers. Send to three copies to Kansas Department of Health and Environment, Bureau of Water Protection, Topeka, Kansas 66620-7320, Telephone: 913-862-9360. Send one to WATER WELL OWNER and retain one for your records.

OFFICE USE ONLY  
T  
R  
E  
M  
SEC.