

USE TYPEWRITER OR BALL POINT PEN-PRESS FIRMLY, PRINT CLEARLY.

T R EW sec 1/4 1/4 1/4 No.


WATER WELL RECORD
KSA 82a-1201-1215

Kansas State Dept. Of Health
(Water Well Contractors)
Forbes-Bldg. 740
Topeka, Kansas 66620

DBC

1 Location of well: County **Ford** Township name **Grandview** Fraction **NW SE SW SW SW** Section number **22** Town number **26-S** Range number **24-W**

Distance and direction from nearest town or city: **3 miles east 1/2 south of Dodge city**
Street address of well location if in city: _____
3 Owner of well: **Farmland**
Address: **Kansas City, Missouri**

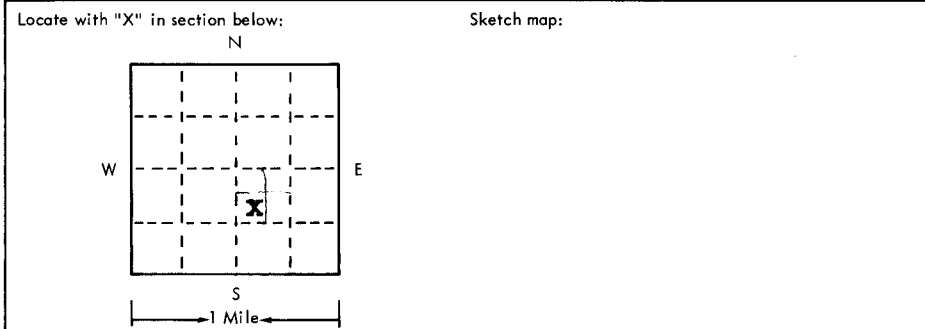

4 Well depth: **275** ft. Date of completion **5-17-75**
Well diameter **5** in.
5 Cable tool Rotary Driven Dug
 Hollow rod Jetted Bored Reverse rotary
6 Use: Domestic Public supply Industry
 Irrigation Air conditioning Commercial
 Test well _____
7 Casing: **plastic** Height: above **4** low
Threaded Welded Surface **12** in.
Diam. _____ Weight **1.8** lbs./ft. _____
5 in. to _____ ft. depth Drive shoe? Yes No
_____ in. to _____ ft. depth!

2	Type and color of material	From	To
	Surface	0	3
	Sandy brown clay	3	38
	Coleche clay and rock	38	70
	Fine sand and clay 50%	70	76
	Brown clay	76	90
	Coleche rock and sand rock and clay	90	110
	Fine sand 15% clay	110	135
	Brown and yellow clay	135	152
	Hard rock	152	153
	Yellow and brown clay	153	166
	Hard purple rock	166	167
	Gray shale rock stringers and yellow clay	167	210
	Gray shale and red bed	210	225
	Gray shale 25% rock	225	227
	Gray shale	227	235
	Good brown sand (use cross sheet if needed)	235	265

8 Screen: **30' screen superior**
Manufacturer **superior**
Type **15%** Dia. **4" 5"**
Slot/gauze **1/16** Length **4" 5"**
Set between **210** ft. and **275** ft. _____
Fittings:
Gravel pack Yes No Size range of material **7/8**
9 Static water level: **180** ft. below land surface Date **5-16-75**
10 Pumping level below land surfaces:
190 ft. after **2** hrs. pumping **30** g.p.m.
_____ ft. after _____ hrs. pumping _____ g.p.m.
Estimated maximum yield **30** g.p.m.
11 Water sample submitted:
 Yes No Date _____
12 Well head completion:
 Pitless adapter **12** inches above grade
13 Well grouted? Yes No
 Neat cement Bentonite _____
Depth: From **3** ft. to **13** ft.
14 Nearest source of possible contamination:
ft. **no** Direction _____ Type _____
Well disinfected upon completion? Yes No
15 Pump: **Reda** Not installed
Manufacturer's name **Reda Pump Co.**
Model number **19D18P201** **2** Volts **220**
Length of drop pipe **210** ft. capacity **30** g.p.m.
Type:
 Submersible Turbine
 Jet Reciprocating
 Centrifugal Other

16 Remarks: **Gray shale and rock stringers red bed 20%**
265 275

Topography:
 Hill
 Slope
 Upland
 Valley

1310 ROCK 155'
1040 CRATER
2452

17 Water well contractor's certification:
This well was drilled under my jurisdiction and this report is true to the best of my knowledge and belief.
Acc Hi Drilling Co. 190
Business name _____ License No. _____
Address **Box 1442 Dodge City, Ks.**
Signed **Carl G. Jettel** Date **6-7-75**
Authorized representative