


1 LOCATION OF WATER WELL: Fraction SW 1/4 SE 1/4 SW 1/4 Section Number 12 Township Number T 26 S Range Number R 24 E (M)
 County: Ford

Distance and direction from nearest town or city street address of well if located within city?
2301 Joel Dodge City
 2 WATER WELL OWNER: Tom Schaffer
 RR#, St. Address, Box #: 2223 6th Ave. Board of Agriculture, Division of Water Resources
 City, State, ZIP Code: Dodge City, KS, 67801 Application Number:

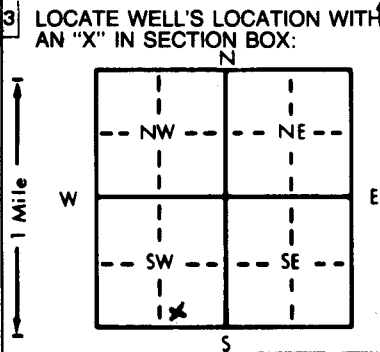

4 DEPTH OF COMPLETED WELL: 310' ft. ELEVATION: ft.
 Depth(s) Groundwater Encountered 1. ft. 2. ft. 3. ft.
 WELL'S STATIC WATER LEVEL: 109' ft. below land surface measured on mo/day/yr 9-8-93
 Pump test data: Well water was ft. after hours pumping gpm
 Est. Yield gpm; Well water was ft. after hours pumping gpm
 Bore Hole Diameter: 9 7/8" in. to ft., and in. to ft.
 WELL WATER TO BE USED AS: 5 Public water supply 8 Air conditioning 11 Injection well
 Domestic 3 Feedlot 6 Oil field water supply 9 Dewatering 12 Other (Specify below)
 2 Irrigation 4 Industrial 7 Lawn and garden only 10 Monitoring well
 Was a chemical/bacteriological sample submitted to Department? Yes.....No X..... If yes, mo/day/yr sample was submitted
 Water Well Disinfected? Yes X No

5 TYPE OF BLANK CASING USED: 5 Wrought iron 8 Concrete tile CASING JOINTS: Glued X Clamped
 1 Steel 3 RMP (SR) 6 Asbestos-Cement 9 Other (specify below) Welded
 PVC 4 ABS 7 Fiberglass Threaded
 Blank casing diameter: 5" in. to 190' ft., Dia in. to ft., Dia in. to ft.
 Casing height above land surface: 12" in., weight lbs./ft. Wall thickness or gauge No. SOR 21
 TYPE OF SCREEN OR PERFORATION MATERIAL: 7 PVC 10 Asbestos-cement
 1 Steel 3 Stainless steel 5 Fiberglass 8 RMP (SR) 11 Other (specify)
 2 Brass 4 Galvanized steel 6 Concrete tile 9 ABS 12 None used (open hole)
 SCREEN OR PERFORATION OPENINGS ARE: 5 Gauzed wrapped 8 Saw cut 11 None (open hole)
 1 Continuous slot 3 Mill slot 6 Wire wrapped 9 Drilled holes
 2 Louvered shutter 4 Key punched 7 Torch cut 10 Other (specify)
 SCREEN-PERFORATED INTERVALS: From 190' ft. to 210' ft., From ft. to ft.
 From ft. to ft., From ft. to ft.
 GRAVEL PACK INTERVALS: From 23' ft. to 210' ft., From ft. to ft.
 From ft. to ft., From ft. to ft.

6 GROUT MATERIAL: 1 Neat cement 2 Cement grout 3 Bentonite 4 Other
 Grout Intervals: From 3' ft. to 23' ft., From ft. to ft., From ft. to ft.
 What is the nearest source of possible contamination: 10 Livestock pens 14 Abandoned water well
 1 Septic tank 4 Lateral lines 7 Pit privy 11 Fuel storage 15 Oil well/Gas well
 2 Sewer lines 5 Cess pool 8 Sewage lagoon 12 Fertilizer storage 16 Other (specify below)
 Watertight sewer lines 6 Seepage pit 9 Feedyard 13 Insecticide storage
 Direction from well? North How many feet? 80'

FROM	TO	LITHOLOGIC LOG	FROM	TO	PLUGGING INTERVALS
0	2	Topsoil	170	175	Brown sandy clay
2	46	Brown clay + caliche mixed	175	310	med. sand + yellow clay shale
46	49	Caliche + Sandrock layers			
49	72	Brown clay + caliche mixed			
72	89	Sandrock + med. sand			
89	95	Brown clay			
95	108	Fine to med sand w/ brown clay			
108	110	Brown clay			
110	124	Fine sand			
124	126	Fine to med sand			
126	140	Brown clay			
140	146	med. sand			
146	148	Brown sandy clay			
148	158	med. sand			
158	170	Brown clay			

7 CONTRACTOR'S OR LANDOWNER'S CERTIFICATION: This water well was (1) constructed, (2) reconstructed, or (3) plugged under my jurisdiction and was completed on (mo/day/year) 9-8-93 and this record is true to the best of my knowledge and belief. Kansas Water Well Contractor's License No. 533 This Water Well Record was completed on (mo/day/yr) 9-13-93 under the business name of Jantzen Water Well Repair by (signature) [Signature]

INSTRUCTIONS: Use typewriter or ball point pen. PLEASE PRESS FIRMLY and PRINT clearly. Please fill in blanks, underline or circle the correct answers. Send up three copies to Kansas Department of Health and Environment, Bureau of Water, Topeka, Kansas 66620-0001. Telephone: 913-296-5545. Send one to WATER WELL OWNER and retain one for your records.