

WRIGHT

USE TYPEWRITER OR BALL POINT PEN-PRESS FIRMLY, PRINT CLEARLY.


WATER WELL RECORD
KSA 82a-1201-1215

Kansas Department of Health and Environment-Division of Environment
(Water well Contractors)
Topeka, Kansas 66620

CDD

1. Location of well: County **FORD** Fraction **SE 1/4 SE 1/4 SW 1/4** Section number **13** Township number **T 26 S R 24 E/W**

2. Distance and direction from nearest town or city: **1/2 mile E Dodge Hwy 80 & Pass**
3. Owner of well: **Bainy Cont By Dicon Cont**
R.R. or street: **Dodge City, ks 67801**
City, state, zip code:

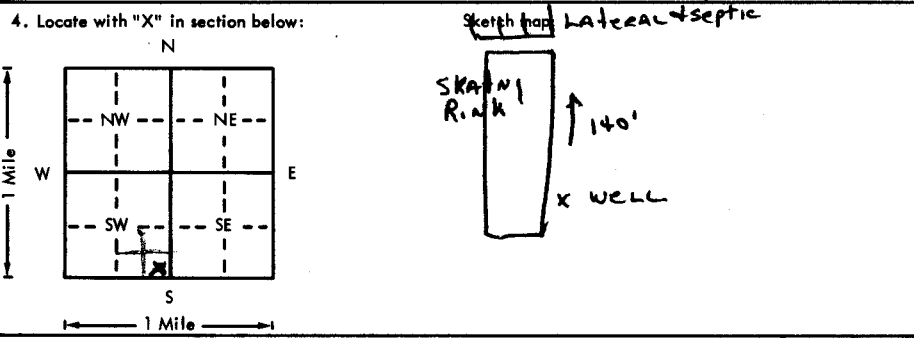

6. Bore hole dia. **9** in. Completion date **10/15/16**
Well depth **230** ft.
7. Cable tool Rotary Driven Dug
 Hollow rod Jetted Bored Reverse rotary
8. Use: Domestic Public supply Industry
 Irrigation Air conditioning Stock
 Lawn Oil field water Other
9. Casing: Material **PVC** Height: **Above** or below
Threaded Welded Surface **19** in.
RMP **PVC Blue** Weight **250** lbs./ft.
Dia. **5** in. to **230** ft. depth Wall Thickness: inches or
Dia. in. to ft. depth gage No. **250**

5. Type and color of material	From	To
Topsoil	0	3
Clay	3	41
Clay & Rock	41	102
SAND	102	104
Clay	104	201
GRAVEL	201	229
Shale	229	230
(Use a second sheet if needed)		

10. Screen: Manufacturer's name **Jess & Lowell**
Type **BVC** Dia. **5**
Gauge **116** Length **3**
Set between **200** ft. and **230** ft.
Gravel pack? Size range of material **1/8**

11. Static water level: **100** ft. below land surface Date **10/15/16**
12. Pumping level below land surfaces: **N/A**
ft. after hrs. pumping g.p.m.
ft. after hrs. pumping g.p.m.
Estimated maximum yield g.p.m.

13. Water sample submitted: Yes No Date
14. Well head completion: Pitless **19** inches above grade
15. Well grouted?
With: Neat cement Bentonite Concrete
Depth: From **0** ft. to **80** ft.

16. Nearest source of possible contamination: **140** ft. Direction **North** Type **Septic**
Well disinfected upon completion? Yes No

17. Pump: Not installed
Manufacturer's name **Reax**
Model number **70108P** HP **3/4** Volts **208**
Length of drop pipe **189** ft. capacity **9** g.p.m.
Type: Submersible Turbine
 Jet Reciprocating
 Centrifugal Other

18. Elevation: Topography: Hill Slope Upland Valley
19. Remarks: **TOPO**
2521
229
2292

20. Water well contractor's certification: This well was drilled under my jurisdiction and this report is true to the best of my knowledge and belief.
CRACE DRILLING **111**
Business name License No.
Address **Rt 1 Dodge City, ks**
Signed **Ray Drury** Date **10/16/16**
Authorized representative

26 24 W 13 SE SE SW
 T R E Sec
 1/4 1/4 1/4