

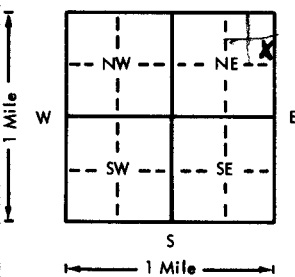
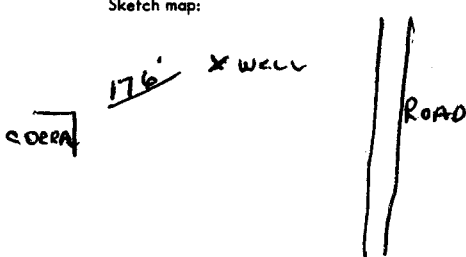
USE TYPEWRITER OR BALL
POINT PEN-PRESS FIRMLY,
PRINT CLEARLY.

WATER WELL RECORD
KSA 82a-1201-1215

Kansas Department of Health and
Environment-Division of Environment
(Water well Contractors)
Topeka, Kansas 66620

WRIGHT

A A D

1. Location of well: FORO		County: FORO		Fraction: SE 1/4 NE 1/4 NE 1/4		Section number: 13		Township number: T 26		Range number: S R 24		E/W: E/W			
2. Distance and direction from nearest town or city: 1 mile NE						3. Owner of well: Don Abel									
Street address of well location if in city:						R.R. or street: 2317 Thompson									
						City, state, zip code: Dodge City KS									
4. Locate with "X" in section below: 						Sketch map: 						6. Bore hole dia. 8 in. Completion date 2/13/16			
												Well depth 200 ft.			
												7. <input checked="" type="checkbox"/> Cable tool <input checked="" type="checkbox"/> Rotary <input type="checkbox"/> Driven <input type="checkbox"/> Dug			
												<input type="checkbox"/> Hollow rod <input type="checkbox"/> Jetted <input type="checkbox"/> Bored <input type="checkbox"/> Reverse rotary			
												8. Use: <input checked="" type="checkbox"/> Domestic <input type="checkbox"/> Public supply <input type="checkbox"/> Industry			
												<input type="checkbox"/> Irrigation <input type="checkbox"/> Air conditioning <input checked="" type="checkbox"/> Stock			
												<input type="checkbox"/> Lawn <input type="checkbox"/> Oil field water <input type="checkbox"/> Other			
						9. Casing: Material AC Height Above or below									
						Threaded <input type="checkbox"/> Welded <input type="checkbox"/> Surface 16 in.									
						RMP <input type="checkbox"/> PVC PVC Weight 1250 lbs./ft.									
						Dia. 5 in. to 200 ft. depth								Wall Thickness: inches or	
						Dia. 5 in. to 200 ft. depth								gauge No. 250	
5. Type and color of material						From		To							
Topsoil						0		2		10. Screen: Manufacturer's name Jess & Lowell					
Clay						2		64		Type PVC Dia. 5					
Rock						64		67		Slot/gauze 1 1/4 Length 3					
Clay						67		79		Set between 170 ft. and 200 ft.					
SAND & CLAY						79		109		ft. and 200 ft.					
Clay & Rock						109		171		Gravel pack? <input checked="" type="checkbox"/> Size range of material 1/8					
GRAVEL						171		200		11. Static water level: 104 ft. below land surface Date 2/13/16					
SHALE						200				12. Pumping level below land surfaces: N/A					
										ft. after 3 hrs. pumping 1 g.p.m.					
										ft. after 3 hrs. pumping 1 g.p.m.					
										Estimated maximum yield 1 g.p.m.					
										13. Water sample submitted: Yes <input checked="" type="checkbox"/> No <input type="checkbox"/> Date 2/13/16					
										14. Well head completion: <input checked="" type="checkbox"/> Pitless adapter 16 inches above grade					
										15. Well grouted? <input checked="" type="checkbox"/> With: <input checked="" type="checkbox"/> Neat cement <input type="checkbox"/> Bentonite <input type="checkbox"/> Concrete					
										Depth: From 3 ft. to 13 ft.					
										16. Nearest source of possible contamination: ft. 175 Direction SW Type CORRAL					
										Well disinfected upon completion? <input checked="" type="checkbox"/> Yes <input type="checkbox"/> No					
										17. Pump: <input type="checkbox"/> Not installed					
										Manufacturer's name Reda					
										Model number 140108P HP 1 1/2 Volts 220					
										Length of drop pipe 126 ft. capacity 20 g.p.m.					
										Type: <input checked="" type="checkbox"/> Submersible <input type="checkbox"/> Turbine					
										<input type="checkbox"/> Jet <input type="checkbox"/> Reciprocating					
										<input type="checkbox"/> Centrifugal <input type="checkbox"/> Other					
18. Elevation:						19. Remarks:						20. Water well contractor's certification:			
Topography: <input checked="" type="checkbox"/> Hill <input checked="" type="checkbox"/> Slope <input type="checkbox"/> Upland <input type="checkbox"/> Valley						TOPO						This well was drilled under my jurisdiction and this report is true to the best of my knowledge and belief.			
						2520 200 2320						CRAGG DRILLING License No. 111			
												Address Rt 1 Ock			
												Signed Raymond Date 2/13/16			
												Authorized representative			

26
24
13
SENE
1/4 1/4 1/4