


WATER WELL RECORD Form WWC-5 KSA 82a-1212

1 LOCATION OF WATER WELL: Fraction Section Number Township Number Range Number
 COUNTY: FORD SE 1/4 SW 1/4 SE 1/4 13 T 26 S R 24 W

Distance and direction from nearest town or city street address of well if located within city?
 BOX 53 WRIGHT, KS 67882- on right - bounded by 3rd house east of Main street on West side of road

2 WATER WELL OWNER: EDWARD DOWNEY Board of Agriculture, Division of Water Resources
 RR#, St. Address, Box #: BOX 53 Application Number:
 City, State, ZIP code: WRIGHT, KS 67882-

3 LOCATE WELL'S LOCATION WITH AN "X" IN SECTION BOX: 4 DEPTH OF COMPLETED WELL 130 ELEVATION: 0
 Depth(s) Groundwater Encountered 1. 0 ft. 2. 0 ft. 3. 0 ft.

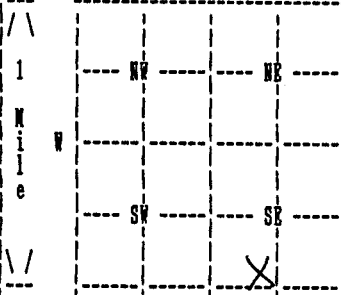

WELL'S STATIC WATER LEVEL 85 ft. below land surface measured on no/day/yr 09/01/92
 Pump testdata: Well water was 0 ft. after 0 hours pumping 0 gpm

Estimated Yield 35 gpm: Well water was 0 ft. after 0 hours pumping 0 gpm

Bore Hole Diameter 10 in. to 130 ft., and in. to 0 ft.

WELL WATER TO BE USED AS: DOMESTIC

Was a chemical/bacteriological sample submitted to department? No ;
 If yes, no/day/yr sample was submitted Water well disinfected? Yes

5 TYPE OF BLANK CASING USED: PVC CASING JOINTS: GLOUED
 Blank casing diameter 5 in. to 130 ft., Dia in. to 0 ft., Dia in. to 0 ft.
 Casing height above land surface 12 in., weight 200 lbs/ft. Wall thickness or gauge No. 21
 TYPE OF SCREEN OR PERFORATION MATERIAL: PVC
 SCREEN OR PERFORATION OPENINGS ARE: SAW CUT

SCREEN PERFORATED INTERVALS: From 102 ft. to 120 ft., From 0 ft. to 0 ft.
 From 0 ft. to 0 ft., From 0 ft. to 0 ft.
 GRAVEL PACK INTERVALS: From 30 ft. to 130 ft., From 0 ft. to 0 ft.
 From 0 ft. to 0 ft., From 0 ft. to 0 ft.

6 GROUT MATERIAL BENTONITE
 Grout intervals: From 5 ft. to 30 ft., From 0 ft. to 0 ft., From 0 ft. to 0 ft.
 What is the nearest source of possible contamination: SEWER LINES
 Direction from well? WEST How many feet? 75

FROM	TO	LITHOLOGIC LOG	FROM	TO	PLUGGING INTERVALS
0	20	TOPSOIL CLAY			
20	40	CLAY			
40	60	CLAY THIN ROCK LAYER			
60	80	FINE SAND ROCK LAYERS			
80	95	FINE SAND ROCK LAYERS CLAY LAYERS			
95	120	MED-COARSE SAND			
120	140	CLAY ROCK LAYERS			

7 CONTRACTOR'S OR LANDOWNER'S CERTIFICATION: This water well was Constructed under my jurisdiction and was completed on (no/day/year) 09/03/92 and this record is true to the best of my knowledge and belief. Kansas Water Well Contractor's License No. 179 This Water Well Record was completed on (no/day/yr) 09/16/92 under the business name of JOE'S WELL SERVICE, INC. by (signature) *Joseph Crick*