

USE TYPEWRITER OR BALL POINT PEN-PRESS FIRMLY, PRINT CLEARLY.


WATER WELL RECORD
KSA 82a-1201-1215

WRIGHT

Kansas Department of Health and Environment-Division of Environment
(Water well Contractors)
Topeka, Kansas 66620

1. Location of well: County Ford Fraction SE 1/4 SE 1/4 NE 1/4 Section number I4 Township number T 26 Range number S R24 E/W

2. Distance and direction from nearest town or city: IN, 1/2 W, 3. Owner of well: Vernon Lix
Street address of well location if in city: of Wright R.R. or street:
City, state, zip code: Wright, Ks 67882

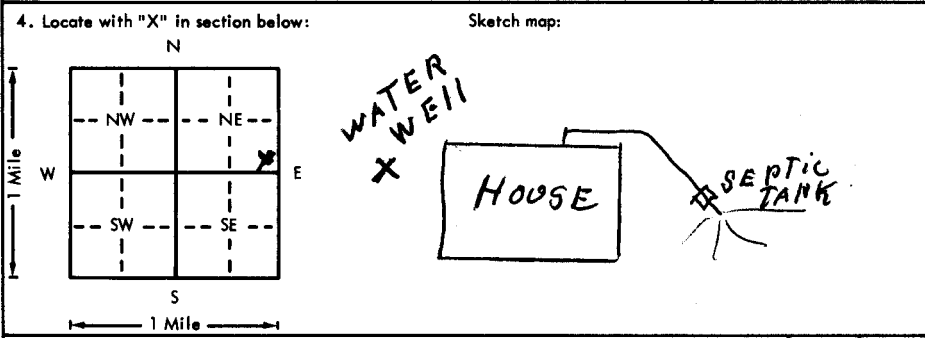

6. Bore hole dia. 8 in. Completion date _____
Well depth 105 ft. 7-5-76
7. Cable tool Rotary Driven Dug
 Hollow rod Jetted Bored Reverse rotary
8. Use: Domestic Public supply Industry
 Irrigation Air conditioning Stock
 Lawn Oil field water Other
9. Casing: Material plts Height: Above or below
Threaded Welded gl Surface I8 in.
RMP PVC Weight _____ lbs./ft.
Dia. 5 in. to 80 ft. depth Wall Thickness: inches or
Dia. _____ in. to _____ ft. depth gage No. 0.250

5. Type and color of material	From	To
Topsoil	0	2
Clay White	2	50
Rock white	50	80
Clay white with sand streaks	80	105
ROCK 105		
64		
41' salt thick		

10. Screen: Manufacturer's name Sunflower
Plastics Pipe, Inc.
Type RMP Dia. 5 in
Slot/gauze 1/16 Length 25
Set between 80 ft. and 105 ft.
Gravel pack? Yes Size range of material 1-1/8
11. Static water level: _____ mo./day/yr.
64 ft. below land surface Date 6-8-76
12. Pumping level below land surfaces:
74 ft. after 2 hrs. pumping 20 g.p.m.
_____ ft. after _____ hrs. pumping _____ g.p.m.
Estimated maximum yield 30 g.p.m.
13. Water sample submitted: _____ mo./day/yr.
Yes No Date _____
14. Well head completion:
 Pitless adapter I8 inches above grade
15. Well grouted? Yes
With: Neat cement Bentonite Concrete
Depth: From 3 ft. to 15 ft.
16. Nearest source of possible contamination:
ft. 2650 Direction S Type well
Well disinfected upon completion? Yes No
17. Pump: _____ Not installed
Manufacturer's name Aermotor
Model number SDI9 HP 3/4 Volt 220
Length of drop pipe 100 ft. capacity 19 g.p.m.
Type:
 Submersible Turbine
 Jet Reciprocating
 Centrifugal Other

18. Elevation: _____ Topography: _____ Hill _____ Slope _____ Upland Valley _____
19. Remarks: Concrete slab was installed
2515
102
20. Water well contractor's certification:
This well was drilled under my jurisdiction and this report is true to the best of my knowledge and belief.
Knoefler Bros. Drilling
Business name _____ License No. _____
Address Jetmore, Ks I30
Signed Dale Knoefler Date 8-24-76
Authorized representative

26 24 14 SESENE 1/4 1/4 1/4