


1 LOCATION OF WATER WELL: County: **Ford** Fraction: **SW-SE 1/4 NW 1/4 NE 1/4** Section Number: **20** Township Number: **T 26 S** Range Number: **R 24 EW**  
 Distance and direction from nearest town or city street address of well if located within city?  
**2 miles North of Dodge City**

2 WATER WELL OWNER: **Ford County Landfill** Board of Agriculture, Division of Water Resources  
 RR#, St. Address, Box #: **Jetmore Star Route** Application Number: **#3**  
 City, State, ZIP Code: **Dodge City, Ks. 67801**

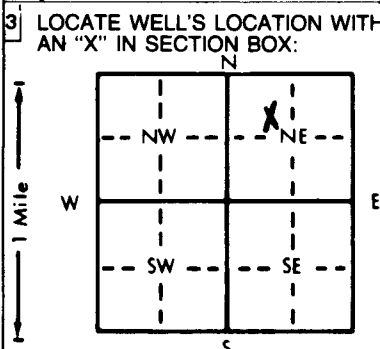

4 DEPTH OF COMPLETED WELL: **160** ft. ELEVATION: ..... ft.  
 Depth(s) Groundwater Encountered: **1** ft. **2** ..... ft. **3** ..... ft.  
 WELL'S STATIC WATER LEVEL: **144' 3.0"** ft. below land surface measured on mo/day/yr  
 Pump test data: Well water was ..... ft. after ..... hours pumping ..... gpm  
 Est. Yield ..... gpm: Well water was ..... ft. after ..... hours pumping ..... gpm  
 Bore Hole Diameter: **8** in. to **160** ft., and ..... in. to ..... ft.  
 WELL WATER TO BE USED AS:  
 5 Public water supply 8 Air conditioning 11 Injection well  
 1 Domestic 3 Feedlot 6 Oil field water supply 9 Dewatering 12 Other (Specify below)  
 2 Irrigation 4 Industrial 7 Lawn and garden only 10 Monitoring well  
 Was a chemical/bacteriological sample submitted to Department? Yes.....No.....**X**.....; If yes, mo/day/yr sample was submitted  
 Water Well Disinfected? Yes No **X**

5 TYPE OF BLANK CASING USED:  
 1 Steel 3 RMP (SR) 5 Wrought iron 8 Concrete tile CASING JOINTS: Glued ..... Clamped .....  
 2 PVC 4 ABS 6 Asbestos-Cement 9 Other (specify below) Welded .....  
 7 Fiberglass ..... Threaded... **X**.....  
 Blank casing diameter **4** in. to **120** ft., Dia ..... in. to ..... ft., Dia ..... in. to ..... ft.  
 Casing height above land surface: **30** in., weight **2.071** lbs./ft. Wall thickness or gauge No. **237**  
 TYPE OF SCREEN OR PERFORATION MATERIAL:  
 1 Steel 3 Stainless steel 5 Fiberglass 7 PVC 10 Asbestos-cement  
 2 Brass 4 Galvanized steel 6 Concrete tile 8 RMP (SR) 11 Other (specify) .....  
 9 ABS 12 None used (open hole)  
 SCREEN OR PERFORATION OPENINGS ARE:  
 1 Continuous slot 3 Mill slot 5 Gauzed wrapped 8 Saw cut 11 None (open hole)  
 2 Louvered shutter 4 Key punched 6 Wire wrapped 9 Drilled holes  
 7 Torch cut 10 Other (specify) .....  
 SCREEN-PERFORATED INTERVALS: From **120** ft. to **160** ft., From ..... ft. to ..... ft.  
 GRAVEL PACK INTERVALS: From **115** ft. to **160** ft., From ..... ft. to ..... ft.

6 GROUT MATERIAL: 1 Neat cement 2 Cement grout **3 Bentonite** 4 Other  
 Grout Intervals: From **0** ft. to **100** ft., From **100** ft. to **115** ft., From ..... ft. to ..... ft.  
 What is the nearest source of possible contamination:  
 1 Septic tank 4 Lateral lines 7 Pit privy 10 Livestock pens 14 Abandoned water well  
 2 Sewer lines 5 Cess pool 8 Sewage lagoon 11 Fuel storage 15 Oil well/Gas well  
 3 Watertight sewer lines 6 Seepage pit 9 Feedyard 12 Fertilizer storage 16 Other (specify below)  
 13 Insecticide storage **Landfill Pits**  
 Direction from well? How many feet? **150'**

FROM	TO	LITHOLOGIC LOG	FROM	TO	PLUGGING INTERVALS
0	3	Surface	157	160	Sand
3	60	Silty Clay, Clay & Caliche	160	170	Fine Brown Sand/Clay Strks.
60	70	Caliche			
70	80	Caliche & Clay Strks.			
80	90	Caliche & Sand			
90	91	Rock			
91	100	Cemented Sand & Clay			
100	110	Clay			
110	120	Clay w/Brwn Fine Sand Strks.			
120	130	Fine to Med Brwn Sand&Clay Strk			
130	141	Clay, Sand Strks, & Caliche			
141	145	Fine Tight Sand			
145	150	Caliche & Clay Strks.			
150	154	Sand			
154	157	Caliche			

7 CONTRACTOR'S OR LANDOWNER'S CERTIFICATION: This water well was (1) constructed, (2) reconstructed, or (3) plugged under my jurisdiction and was completed on (mo/day/year) **4-28-93** and this record is true to the best of my knowledge and belief. Kansas Water Well Contractor's License No. **554**. This Water Well Record was completed on (mo/day/yr) **5-5-93** under the business name of **WOOFTER PUMP & WELL, INC.** by (signature) *[Signature]*