


1 LOCATION OF WATER WELL: County: **Ford** Fraction: **SW-SE 1/4 SW 1/4 SW 1/4** Section Number: **20** Township Number: **T 26 S** Range Number: **R 24** **EW**

Distance and direction from nearest town or city street address of well if located within city?
2 miles North of Dodge City

2 WATER WELL OWNER: **Ford County Landfill**
 RR#, St. Address, Box #: **Jetmore Star Route** Board of Agriculture, Division of Water Resources
 City, State, ZIP Code: **Dodge City, Ks. 67801 #4** Application Number:

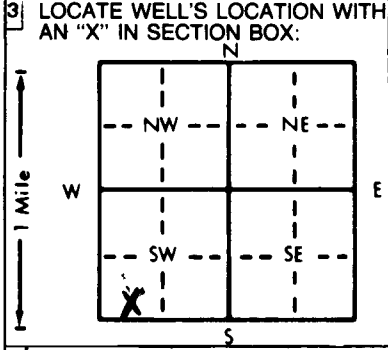

4 DEPTH OF COMPLETED WELL: **140** ft. ELEVATION: _____
 Depth(s) Groundwater Encountered 1. _____ ft. 2. _____ ft. 3. _____ ft.
 WELL'S STATIC WATER LEVEL **119' 7.6"** ft. below land surface measured on mo/day/yr
 Pump test data: Well water was _____ ft. after _____ hours pumping _____ gpm
 Est. Yield _____ gpm: Well water was _____ ft. after _____ hours pumping _____ gpm
 Bore Hole Diameter: **8** in. to **140** ft., and _____ in. to _____ ft.
 WELL WATER TO BE USED AS:
 5 Public water supply 8 Air conditioning 11 Injection well
 1 Domestic 3 Feedlot 6 Oil field water supply 9 Dewatering 12 Other (Specify below)
 2 Irrigation 4 Industrial 7 Lawn and garden only 10 Monitoring well
 Was a chemical/bacteriological sample submitted to Department? Yes _____ No **X**; If yes, mo/day/yr sample was submitted
 Water Well Disinfected? Yes _____ No **X**

5 TYPE OF BLANK CASING USED:
 1 Steel 3 RMP (SR) 5 Wrought iron 8 Concrete tile CASING JOINTS: Glued _____ Clamped _____
 2 PVC 4 ABS 6 Asbestos-Cement 9 Other (specify below) Welded _____
 7 Fiberglass Threaded **X**
 Blank casing diameter **4** in. to **100** ft., Dia _____ in. to _____ ft., Dia _____ in. to _____ ft.
 Casing height above land surface: **30** in., weight **2.071** lbs./ft. Wall thickness or gauge No. **237**
 TYPE OF SCREEN OR PERFORATION MATERIAL:
 1 Steel 3 Stainless steel 5 Fiberglass 7 PVC 10 Asbestos-cement
 2 Brass 4 Galvanized steel 6 Concrete tile 8 RMP (SR) 11 Other (specify) _____
 9 ABS 12 None used (open hole)
 SCREEN OR PERFORATION OPENINGS ARE:
 1 Continuous slot 3 Mill slot 5 Gauzed wrapped 8 Saw cut 11 None (open hole)
 2 Louvered shutter 4 Key punched 6 Wire wrapped 9 Drilled holes
 7 Torch cut 10 Other (specify) _____
 SCREEN-PERFORATED INTERVALS: From **100** ft. to **140** ft., From _____ ft. to _____ ft.
 From **95** ft. to **140** ft., From _____ ft. to _____ ft.
 GRAVEL PACK INTERVALS: From _____ ft. to _____ ft., From _____ ft. to _____ ft.

6 GROUT MATERIAL: 1 Neat cement 2 Cement grout 3 Bentonite 4 Other _____
 Grout Intervals: From **0** ft. to **80** ft., From **80** ft. to **95** ft., From _____ ft. to _____ ft.
 What is the nearest source of possible contamination:
 1 Septic tank 4 Lateral lines 7 Pit privy 10 Livestock pens 14 Abandoned water well
 2 Sewer lines 5 Cess pool 8 Sewage lagoon 11 Fuel storage 15 Oil well/Gas well
 3 Watertight sewer lines 6 Seepage pit 9 Feedyard 12 Fertilizer storage 16 Other (specify below)
 13 Insecticide storage **Landfill Pits**
 Direction from well? How many feet? **150'**

FROM	TO	LITHOLOGIC LOG	FROM	TO	PLUGGING INTERVALS
0	3	Surface	110	120	Cemented Sand w/few sand strks
3	10	Clay	120	130	Clay, Caliche & some Fine sand
10	40	Clay & Caliche	130	140	Fine Sand w/Clay Strks.
40	50	Caliche, Sandy Clay & Fine Sand			
50	55	Fine Sand			
55	60	Caliche			
60	61	Caliche			
61	65	Sand			
65	70	Clay			
70	80	Clay & Caliche			
80	83	Med. Sand			
83	88	Clay Caliche & Fine Sand Strks			
88	90	Clay			
90	100	Clay & Caliche			
100	110	Calich, Cemented & Clay Strks.			

7 CONTRACTOR'S OR LANDOWNER'S CERTIFICATION: This water well was (1) constructed, (2) reconstructed, or (3) plugged under my jurisdiction and was completed on (mo/day/year) **4-29-93** and this record is true to the best of my knowledge and belief. Kansas Water Well Contractor's License No. **554** This Water Well Record was completed on (mo/day/yr) **5-5-93** under the business name of **WOOFER PUMP & Well, Inc.** by (signature) *Gayle Woofler*