


1 LOCATION OF WATER WELL: County: <b>Ford</b>	Fraction <b>SW-SW<sup>1</sup>/<sub>4</sub> SW <sup>1</sup>/<sub>4</sub> SE <sup>1</sup>/<sub>4</sub></b>	Section Number <b>20</b>	Township Number <b>T 26 S</b>	Range Number <b>R 24 E/W</b>
--	---	-----------------------------	----------------------------------	---------------------------------

Distance and direction from nearest town or city street address of well if located within city?  
**2 Miles North of Dodge City**

2 WATER WELL OWNER: **Ford County Landfill**  
 RR#, St. Address, Box # : **Jetmore Star Route** Board of Agriculture, Division of Water Resources  
 City, State, ZIP Code : **Dodge City, Ks. 67801 #5** Application Number:

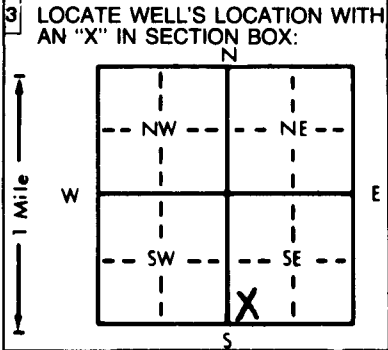

4 DEPTH OF COMPLETED WELL... **180** ft. ELEVATION: .....

Depth(s) Groundwater Encountered 1. .... ft. 2. .... ft. 3. .... ft.

WELL'S STATIC WATER LEVEL **144' 5.3"** ft. below land surface measured on mo/day/yr .....

Pump test data: Well water was ..... ft. after ..... hours pumping ..... gpm

Est. Yield ..... gpm: Well water was ..... ft. after ..... hours pumping ..... gpm

Bore Hole Diameter... **8** in. to **180** ft., and ..... in. to ..... ft.

WELL WATER TO BE USED AS: 5 Public water supply 8 Air conditioning 11 Injection well  
 1 Domestic 3 Feedlot 6 Oil field water supply 9 Dewatering 12 Other (Specify below)  
 2 Irrigation 4 Industrial 7 Lawn and garden only 10 Monitoring well .....

Was a chemical/bacteriological sample submitted to Department? Yes.....No **X**.....; If yes, mo/day/yr sample was submitted

Water Well Disinfected? Yes No **X**

5 TYPE OF BLANK CASING USED:

1 Steel	3 RMP (SR)	6 Asbestos-Cement	9 Other (specify below)	Welded .....
2 PVC	4 ABS	7 Fiberglass		Threaded <b>X</b> .....

Blank casing diameter ..... **4** in. to ..... **120** ft., Dia ..... in. to ..... ft., Dia ..... in. to ..... ft.

Casing height above land surface ..... **30** in., weight ..... **2.071** lbs./ft. Wall thickness or gauge No. **.237**

TYPE OF SCREEN OR PERFORATION MATERIAL:

1 Steel	3 Stainless steel	5 Fiberglass	8 RMP (SR)	11 Other (specify) .....
2 Brass	4 Galvanized steel	6 Concrete tile	9 ABS	12 None used (open hole)

SCREEN OR PERFORATION OPENINGS ARE:

1 Continuous slot	3 Mill slot	5 Gauzed wrapped	8 Saw cut	11 None (open hole)
2 Louvered shutter	4 Key punched	6 Wire wrapped	9 Drilled holes	
		7 Torch cut	10 Other (specify) .....	

SCREEN-PERFORATED INTERVALS: From ..... **120** ft. to ..... **180** ft., From ..... ft. to ..... ft.

GRAVEL PACK INTERVALS: From ..... **115** ft. to ..... **180** ft., From ..... ft. to ..... ft.

6 GROUT MATERIAL: 1 Neat cement 2 **Cement grout** 3 Bentonite 4 Other .....

Grout Intervals: From ..... **0** ft. to ..... **100** ft., From ..... **100** ft. to ..... **115** ft., From ..... ft. to ..... ft.

What is the nearest source of possible contamination:

1 Septic tank	4 Lateral lines	7 Pit privy	10 Livestock pens	14 Abandoned water well
2 Sewer lines	5 Cess pool	8 Sewage lagoon	11 Fuel storage	15 Oil well/Gas well
3 Watertight sewer lines	6 Seepage pit	9 Feedyard	12 Fertilizer storage	16 Other (specify below)
			13 Insecticide storage	<b>Landfill Pits</b> .....

Direction from well? How many feet? **150'**

FROM	TO	LITHOLOGIC LOG	FROM	TO	PLUGGING INTERVALS
0	3	Surface	138	142	Med. Sand
3	20	Silty Clay/Caliche Strks.	142	147	Caliche & Sand Strks.
20	30	Lt. Brown Clay/few Caliche Strk			
30	40	Lt. Brown Clay	147	155	Clay & Caliche Strks.
40	50	Lt. Brown Clay/some Caliche	155	160	Fine Sand
50	60	Clay/Caliche Strks.	160	180	Clay & Fine Sand Strks.
60	70	Clay Caliche Fine Sand Cemented Sand			
70	80	Clay, Sand & hard Caliche			
80	90	Caliche & Med. Sand			
90	100	Caliche strk, Med Sand, Cemented Sand			
100	104	Med. to Fine Sand			
104	111	Caliche & Clay			
111	120	Tan Clay/Caliche & Fine Sand Strks.			
120	129	Fine Silty Sand/Caliche & Clay Strks.			
129	138	Cemented Sand/Caliche & Clay Lyrs.			

7 CONTRACTOR'S OR LANDOWNER'S CERTIFICATION: This water well was (1) constructed, (2) reconstructed, or (3) plugged under my jurisdiction and was completed on (mo/day/year) ... **4-30-93** ... and this record is true to the best of my knowledge and belief. Kansas Water Well Contractor's License No. .... **554** .... This Water Well Record was completed on (mo/day/yr) ... **5-5-93** ... under the business name of **WOOFTER PUMP & Well, Inc.** by (signature) *[Signature]*