


Distance and direction from nearest town or city street address of well if located within city?  
 2 Miles North of Dodge City, Kansas

2] WATER WELL OWNER: Ford County Landfill  
 RR#, St. Address, Box #: Jetmore Star Route  
 City, State, ZIP Code: Dodge City, Ks. 67801 #6  
 Board of Agriculture, Division of Water Resources  
 Application Number:

3] LOCATE WELL'S LOCATION WITH AN "X" IN SECTION BOX:

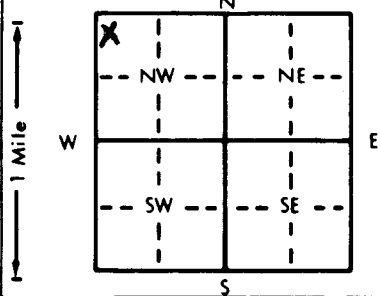

4] DEPTH OF COMPLETED WELL: 160 ft. ELEVATION:  
 Depth(s) Groundwater Encountered 1. ft. 2. ft. 3. ft.  
 WELL'S STATIC WATER LEVEL: 51' 1.1" ft. below land surface measured on mo/day/yr  
 Pump test data: Well water was . . . . . ft. after . . . . . hours pumping . . . . . gpm  
 Est. Yield . . . . . gpm: Well water was . . . . . ft. after . . . . . hours pumping . . . . . gpm  
 Bore Hole Diameter: 8 in. to 160 ft., and . . . . . in. to . . . . . ft.  
 WELL WATER TO BE USED AS:  
 1 Domestic 3 Feedlot 5 Public water supply 8 Air conditioning 11 Injection well  
 2 Irrigation 4 Industrial 6 Oil field water supply 9 Dewatering 12 Other (Specify below)  
 7 Lawn and garden only 10 Monitoring well  
 Was a chemical/bacteriological sample submitted to Department? Yes . . . . . No  . . . . . If yes, mo/day/yr sample was submitted  
 Water Well Disinfected? Yes . . . . . No

5] TYPE OF BLANK CASING USED:  
 1 Steel 3 RMP (SR) 5 Wrought iron 8 Concrete tile CASING JOINTS: Glued . . . . . Clamped . . . . .  
 2 PVC 4 ABS 6 Asbestos-Cement 9 Other (specify below) Welded . . . . .  
 7 Fiberglass Threaded   
 Blank casing diameter: 4 in. to 120 ft., Dia . . . . . in. to . . . . . ft., Dia . . . . . in. to . . . . . ft.  
 Casing height above land surface: 30 in., weight 2.071 lbs./ft. Wall thickness or gauge No. .237  
 TYPE OF SCREEN OR PERFORATION MATERIAL:  
 1 Steel 3 Stainless steel 5 Fiberglass 7 PVC 10 Asbestos-cement  
 2 Brass 4 Galvanized steel 6 Concrete tile 8 RMP (SR) 11 Other (specify) . . . . .  
 9 ABS 12 None used (open hole)  
 SCREEN OR PERFORATION OPENINGS ARE:  
 1 Continuous slot 3 Mill slot 5 Gauzed wrapped 8 Saw cut 11 None (open hole)  
 2 Louvered shutter 4 Key punched 6 Wire wrapped 9 Drilled holes  
 7 Torch cut 10 Other (specify) . . . . .  
 SCREEN-PERFORATED INTERVALS: From 120 ft. to 160 ft., From . . . . . ft. to . . . . . ft.  
 From . . . . . ft. to . . . . . ft., From . . . . . ft. to . . . . . ft.  
 GRAVEL PACK INTERVALS: From 115 ft. to 160 ft., From . . . . . ft. to . . . . . ft.  
 From . . . . . ft. to . . . . . ft., From . . . . . ft. to . . . . . ft.

6] GROUT MATERIAL: 1 Neat cement 2 Cement grout 3 Bentonite 4 Other  
 Grout Intervals: From 0 ft. to 100 ft., From 100 ft. to 115 ft., From . . . . . ft. to . . . . . ft.  
 What is the nearest source of possible contamination:  
 1 Septic tank 4 Lateral lines 7 Pit privy 10 Livestock pens 14 Abandoned water well  
 2 Sewer lines 5 Cess pool 8 Sewage lagoon 11 Fuel storage 15 Oil well/Gas well  
 3 Watertight sewer lines 6 Seepage pit 9 Feedyard 12 Fertilizer storage 16 Other (specify below)  
 13 Insecticide storage Landfill Pits  
 Direction from well? How many feet? 150'

FROM	TO	LITHOLOGIC LOG	FROM	TO	PLUGGING INTERVALS
0	2	Surface	85	90	Caliche/Cemented Sand Strks.
2	12	Silty Clay	90	92	Med. Sand
12	25	Clay & Silty Clay/Fine Cal Strk	92	94	Hard Caliche
25	27	Fine Sand	94	99	Caliche & Clay Strks.
27	38	Clay-Silty & Fine Sand Strks.	99	108	Caliche & Cemented Sand Strk
38	40	Clay	108	111	Med. Sand
40	43	Fine Sand & Thin Clay Layers	111	127	Clay & Fine Sand Strks.
43	45	Clay	127	134	Fine Sand/Fine Clay Lyr.
45	48	Fine Sand	134	136	Clay
48	60	Tan Clay	136	141	Caliche & Clay Strks/
60	68	Clay/Caliche Strks.			Fine Sand Lyr
68	72	Caliche & Clay	141	156	Cemented Sand Strks/F.Sand
72	74	Clay-Tan to White	156	158	Fine Sand
74	77	Caliche	158	159	Caliche
77	85	White Clay/Caliche Strks.	159	160	Sand

7] CONTRACTOR'S OR LANDOWNER'S CERTIFICATION: This water well was (1) constructed, (2) reconstructed, or (3) plugged under my jurisdiction and was completed on (mo/day/year) 5-5-93 and this record is true to the best of my knowledge and belief. Kansas Water Well Contractor's License No. 554 This Water Well Record was completed on (mo/day/yr) 5-10-93 under the business name of WOOFTER PUMP & WELL, INC. by (signature) Jay C. Woofter