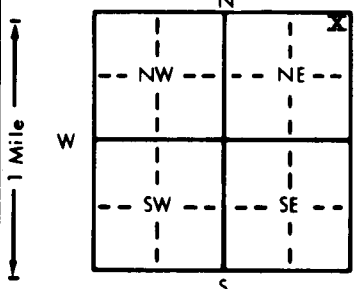


Copy of

1] LOCATION OF WATER WELL: Fraction NE 1/4 NE 1/4 NE 1/4 Section Number 22 Township Number T 26 S Range Number R 24 EW
 County: Ford

Distance and direction from nearest town or city street address of well if located within city?
2 1/2 Miles west of Wright, Kansas

2] WATER WELL OWNER: Farmland Industries Inc.
 RR#, St. Address, Box #: Box 1337
 City, State, ZIP Code: Dodge City, Kansas 67801
 Board of Agriculture, Division of Water Resources
 Application Number:

3] LOCATE WELL'S LOCATION WITH AN "X" IN SECTION BOX:

 4] DEPTH OF COMPLETED WELL: 130 ft. ELEVATION: slope
 Depth(s) Groundwater Encountered 1. 80 ft. 2. _____ ft. 3. _____ ft.
 WELL'S STATIC WATER LEVEL 75 ft. below land surface measured on mo/day/yr 11-18-82
 Pump test data: Well water was _____ ft. after _____ hours pumping _____ gpm
 Est. Yield _____ gpm: Well water was _____ ft. after _____ hours pumping _____ gpm
 Bore Hole Diameter 93/4 in. to 130 ft., and _____ in. to _____ ft.
 WELL WATER TO BE USED AS:
 5 Public water supply 8 Air conditioning 11 Injection well
 1 Domestic 3 Feedlot 6 Oil field water supply 9 Dewatering 12 Other (Specify below)
 2 Irrigation 4 Industrial 7 Lawn and garden only 10 Observation well
 Was a chemical/bacteriological sample submitted to Department? Yes _____ No X _____; If yes, mo/day/yr sample was submitted _____
 Water Well Disinfected? Yes _____ No X _____

5] TYPE OF BLANK CASING USED:
 1 Steel 3 RMP (SR) 5 Wrought iron 8 Concrete tile CASING JOINTS: Glued X Clamped _____
 2 PVC 4 ABS 6 Asbestos-Cement 9 Other (specify below) Welded _____
 7 Fiberglass Threaded _____
 Blank casing diameter 5 in. to 130 ft., Dia _____ in. to _____ ft., Dia _____ in. to _____ ft.
 Casing height above land surface 12 in., weight _____ lbs./ft. Wall thickness or gauge No. SDR 21
 TYPE OF SCREEN OR PERFORATION MATERIAL:
 1 Steel 3 Stainless steel 5 Fiberglass 7 PVC 10 Asbestos-cement
 2 Brass 4 Galvanized steel 6 Concrete tile 8 RMP (SR) 11 Other (specify) _____
 9 ABS 12 None used (open hole)
 SCREEN OR PERFORATION OPENINGS ARE:
 1 Continuous slot 5 Gauzed wrapped 8 Saw cut 11 None (open hole)
 2 Louvered shutter 3 Mill slot 6 Wire wrapped 9 Drilled holes
 4 Key punched 7 Torch cut 10 Other (specify) _____
 SCREEN-PERFORATED INTERVALS: From 100 ft. to 130 ft., From _____ ft. to _____ ft.
 From _____ ft. to _____ ft., From _____ ft. to _____ ft.
 GRAVEL PACK INTERVALS: From 13 ft. to 130 ft., From _____ ft. to _____ ft.
 From _____ ft. to _____ ft., From _____ ft. to _____ ft.

6] GROUT MATERIAL: 1 Neat cement 2 Cement grout 3 Bentonite 4 Other _____
 Grout Intervals: From 3 ft. to 13 ft., From _____ ft. to _____ ft., From _____ ft. to _____ ft.
 What is the nearest source of possible contamination:
 1 Septic tank 4 Lateral lines 7 Pit privy 10 Livestock pens 14 Abandoned water well
 2 Sewer lines 5 Cess pool 8 Sewage lagoon 11 Fuel storage 15 Oil well/Gas well
 3 Watertight sewer lines 6 Seepage pit 9 Feedyard 12 Fertilizer storage 16 Other (specify below)
 13 Insecticide storage none
 Direction from well? _____ How many feet? _____

FROM	TO	LITHOLOGIC LOG	FROM	TO	LITHOLOGIC LOG
0	3	Surface			
3	40	Brown silty clay			
40	60	Caleche clay			
60	75	Green clay 20% sand			
75	80	Brown clay and sand rock			
80	110	60% sand 40% clay			
110	130	Fine sand			
130	150	yellow clay and red sand rock			
150		Brown and gray clay			

7] CONTRACTOR'S OR LANDOWNER'S CERTIFICATION: This water well was (1) constructed, (2) reconstructed, or (3) plugged under my jurisdiction and was completed on (mo/day/year) 11-18-82 and this record is true to the best of my knowledge and belief. Kansas Water Well Contractor's License No. 302 This Water Well Record was completed on (mo/day/yr) 12-29-82 under the business name of Hodde Drilling Co. by (signature) William Hodde

INSTRUCTIONS: Use typewriter or ball point pen, PLEASE PRESS FIRMLY and PRINT clearly. Please fill in blanks, underline or circle the correct answers. Send top three copies to Kansas Department of Health and Environment, Division of Environment, Environmental Geology Section, Topeka, KS 66620. Send one to WATER WELL OWNER and retain one for your records.