


1 LOCATION OF WATER WELL: County: Ford	Fraction NW 1/4 SE 1/4 NW 1/4	Section Number 22	Township Number T 26 S	Range Number R 24 EW
--	---	-----------------------------	----------------------------------	--------------------------------

Distance and direction from nearest town or city street address of well if located within city?
2 1/2 miles from Wright, Kansas

2 WATER WELL OWNER: **Farmland Industries**
 RR#, St. Address, Box # : **HyWay 50 E**
 City, State, ZIP Code : **Dodge City, Kansas 67801**

Board of Agriculture, Division of Water Resources
 Application Number:

3 LOCATE WELL'S LOCATION WITH AN "X" IN SECTION BOX:

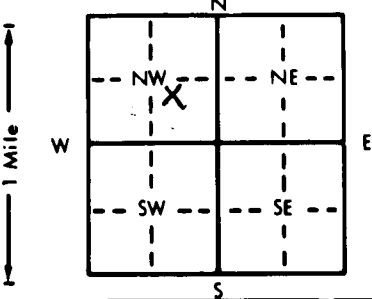

4 DEPTH OF COMPLETED WELL: **135** ft. ELEVATION: **slope**

Depth(s) Groundwater Encountered 1. **45** ft. 2. **92** ft. 3. _____ ft.

WELL'S STATIC WATER LEVEL **45** ft. below land surface measured on mo/day/yr **3-10-83**

Pump test data: Well water was **50** ft. after **3** hours pumping **20** gpm

Est. Yield _____ gpm: Well water was _____ ft. after _____ hours pumping _____ gpm

Bore Hole Diameter **9 3/4** in. to **135** ft., and _____ in. to _____ ft.

WELL WATER TO BE USED AS:

5 Public water supply	8 Air conditioning	11 Injection well
1 Domestic	3 Feedlot	6 Oil field water supply
2 Irrigation	4 Industrial	7 Lawn and garden only
		10 Observation well

Was a chemical/bacteriological sample submitted to Department? Yes _____ No **no**; If yes, mo/day/yr sample was submitted _____

Water Well Disinfected? Yes _____ No **no**

5 TYPE OF BLANK CASING USED:

1 Steel	3 RMP (SR)	5 Wrought iron	8 Concrete tile	CASING JOINTS: Glued X Clamped _____
2 PVC	4 ABS	6 Asbestos-Cement	9 Other (specify below)	Welded _____
		7 Fiberglass		Threaded _____

Blank casing diameter **5** in. to **105** ft., Dia _____ in. to _____ ft., Dia _____ in. to _____ ft.

Casing height above land surface **12** in., weight **3** lbs./ft. Wall thickness or gauge No. **SDR 21**

TYPE OF SCREEN OR PERFORATION MATERIAL:

1 Steel	3 Stainless steel	5 Fiberglass	8 RMP (SR)	10 Asbestos-cement
2 Brass	4 Galvanized steel	6 Concrete tile	9 ABS	11 Other (specify) _____
				12 None used (open hole)

SCREEN OR PERFORATION OPENINGS ARE:

1 Continuous slot	3 Mill slot	5 Gauzed wrapped	8 Saw cut	11 None (open hole)
2 Louvered shutter	4 Key punched	6 Wire wrapped	9 Drilled holes	
		7 Torch cut	10 Other (specify) _____	

SCREEN-PERFORATED INTERVALS: From **105** ft. to **135** ft., From _____ ft. to _____ ft.

GRAVEL PACK INTERVALS: From **13** ft. to **135** ft., From _____ ft. to _____ ft.

6 GROUT MATERIAL: 1 Neat cement **2 Cement grout** 3 Bentonite 4 Other _____

Grout intervals: From **3** ft. to **13** ft., From _____ ft. to _____ ft., From _____ ft. to _____ ft.

What is the nearest source of possible contamination:

1 Septic tank	4 Lateral lines	7 Pit privy	10 Livestock pens	14 Abandoned water well
2 Sewer lines	5 Cess pool	8 Sewage lagoon	11 Fuel storage	15 Oil well/Gas well
3 Watertight sewer lines	6 Seepage pit	9 Feedyard	12 Fertilizer storage	16 Other (specify below)
			13 Insecticide storage	none

Direction from well? _____ How many feet? _____

FROM	TO	LITHOLOGIC LOG	FROM	TO	LITHOLOGIC LOG
0	3	Surface			
3	20	Brown clay			
20	45	Caleche clay			
45	75	Brown clay			
75	92	Caleche clay			
92	115	Brown clay 20% sand			
115	135	Brown sand 35% rest brown clay			
135	165	Yellow clay and red bed			

7 CONTRACTOR'S OR LANDOWNER'S CERTIFICATION: This water well was (1) constructed, (2) reconstructed, or (3) plugged under my jurisdiction and was completed on (mo/day/year) **1-11-83** and this record is true to the best of my knowledge and belief. Kansas Water Well Contractor's License No. **302** This Water Well Record was completed on (mo/day/yr) **5-10-87** under the business name of **Hodde Drilling Co.** by (signature) *Willie Hodde Jr*