


Hodde # 64

1 LOCATION OF WATER WELL:	Fraction	Section Number	Township Number	Range Number
County: Wood	NW 1/4 NE 1/4 NE 1/4	22	T 26 S	R 24 EW

Distance and direction from nearest town or city street address of well if located within city?
2 1/2 miles west of Wright, Kansas

2 WATER WELL OWNER: **Farmland Industries**
 RR#, St. Address, Box #: **HyWay 50 E.** Board of Agriculture, Division of Water Resources
 City, State, ZIP Code: **Dodge City, Kansas 67801** Application Number:

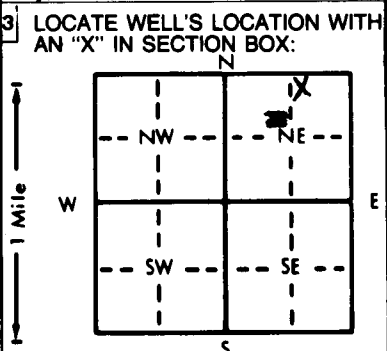

4 DEPTH OF COMPLETED WELL... **135** ft. ELEVATION: **slope**

Depth(s) Groundwater Encountered 1... **55** ft. 2... ft. 3... ft.

WELL'S STATIC WATER LEVEL ... **60** ft. below land surface measured on mo/day/yr ... **10-11-83**

Pump test data: Well water was ... ft. after ... hours pumping ... gpm

Est. Yield ... gpm: Well water was ... ft. after ... hours pumping ... gpm

Bore Hole Diameter **9 3/4** in. to **135** ft., and ... in. to ... ft.

WELL WATER TO BE USED AS:

5 Public water supply	8 Air conditioning	11 Injection well
1 Domestic	3 Feedlot	6 Oil field water supply
2 Irrigation	4 Industrial	7 Lawn and garden only
		10 <u>Observation well</u>

12 Other (Specify below)

Was a chemical/bacteriological sample submitted to Department? Yes.....No...**X**.....; If yes, mo/day/yr sample was submitted

Water Well Disinfected? Yes No **X**

5 TYPE OF BLANK CASING USED:

1 Steel	3 RMP (SR)	5 Wrought iron	8 Concrete tile	CASING JOINTS: Glued .. X .. Clamped ..
2 PVC	4 ABS	6 Asbestos-Cement	9 Other (specify below)	Welded ..
		7 Fiberglass		Threaded ..

Blank casing diameter ... **5** in. to **135** ft., Dia ... in. to ... ft., Dia ... in. to ... ft.

Casing height above land surface ... **12** in., weight ... **3** lbs./ft. Wall thickness or gauge No. ... **SDR 21**

TYPE OF SCREEN OR PERFORATION MATERIAL:

1 Steel	3 Stainless steel	5 Fiberglass	8 RMP (SR)	10 Asbestos-cement
2 Brass	4 Galvanized steel	6 Concrete tile	9 ABS	11 Other (specify) ..
				12 None used (open hole)

SCREEN OR PERFORATION OPENINGS ARE:

1 Continuous slot	3 Mill slot	5 Gauzed wrapped	8 <u>Saw cut</u>	11 None (open hole)
2 Louvered shutter	4 Key punched	6 Wire wrapped	9 Drilled holes	
		7 Torch cut	10 Other (specify) ..	

SCREEN-PERFORATED INTERVALS: From ... **105** ft. to ... **135** ft., From ... ft. to ... ft.

GRAVEL PACK INTERVALS: From ... **13** ft. to ... **135** ft., From ... ft. to ... ft.

6 GROUT MATERIAL: 1 Neat cement 2 Cement grout 3 Bentonite 4 Other

Grout Intervals: From ... **3** ft. to ... **13** ft., From ... ft. to ... ft., From ... ft. to ... ft.

What is the nearest source of possible contamination:

1 Septic tank	4 Lateral lines	7 Pit privy	10 Livestock pens	14 Abandoned water well
2 Sewer lines	5 Cess pool	8 Sewage lagoon	11 Fuel storage	15 Oil well/Gas well
3 Watertight sewer lines	6 Seepage pit	9 Feedyard	12 Fertilizer storage	16 Other (specify below)
			13 Insecticide storage	none

Direction from well? How many feet?

FROM	TO	LITHOLOGIC LOG	FROM	TO	LITHOLOGIC LOG
0	3	Surface			
3	30	Brown clay			
30	55	Galeche clay			
55	110	Sandy clay and rock layers			
110	120	Sandy clay			
120	135	Fine sand			
135	140	Clay			

7 CONTRACTOR'S OR LANDOWNER'S CERTIFICATION: This water well was (1) constructed, (2) reconstructed, or (3) plugged under my jurisdiction and was completed on (mo/day/year) ... **10-11-83** ... and this record is true to the best of my knowledge and belief. Kansas Water Well Contractor's License No. ... **302** ... This Water Well Record was completed on (mo/day/yr) ... **5-10-87** ... under the business name of **Hodde Drilling Co.** by (signature) *Willie Hodde*