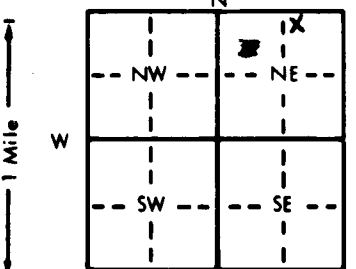


1 LOCATION OF WATER WELL: County: **Ford** Fraction: **NW 1/4 NE 1/4 NE 1/4** Section Number: **22** Township Number: **T 26 S** Range Number: **R 24 EW**

Distance and direction from nearest town or city street address of well if located within city?
2 1/2 miles west of Wright, Kansas

2 WATER WELL OWNER: **Farmland Industries**
 RR#, St. Address, Box #: **HyWay 50 E** Board of Agriculture, Division of Water Resources
 City, State, ZIP Code: **Dodge City, Kansas 67801** Application Number:

3 LOCATE WELL'S LOCATION WITH AN "X" IN SECTION BOX:

 4 DEPTH OF COMPLETED WELL: **140** ft. ELEVATION: **flat**
 Depth(s) Groundwater Encountered 1. **35** ft. 2. ft. 3. ft.
 WELL'S STATIC WATER LEVEL **25** ft. below land surface measured on mo/day/yr **5-8-85**
 Pump test data: Well water was ft. after hours pumping gpm
 Est. Yield gpm: Well water was ft. after hours pumping gpm
 Bore Hole Diameter **9 3/4** in. to **140** ft., and in. to ft.
 WELL WATER TO BE USED AS:
 5 Public water supply 8 Air conditioning 11 Injection well
 1 Domestic 3 Feedlot 6 Oil field water supply 9 Dewatering 12 Other (Specify below)
 2 Irrigation 4 Industrial 7 Lawn and garden only 10 Observation well
 Was a chemical/bacteriological sample submitted to Department? Yes No ; If yes, mo/day/yr sample was submitted
 Water Well Disinfected? Yes No

5 TYPE OF BLANK CASING USED:
 1 Steel 3 RMP (SR) 5 Wrought iron 8 Concrete tile CASING JOINTS: Glued Clamped
 2 PVC 4 ABS 6 Asbestos-Cement 9 Other (specify below) Welded
 7 Fiberglass Threaded
 Blank casing diameter **5** in. to **140** ft., Dia in. to ft., Dia in. to ft.
 Casing height above land surface **12** in., weight **3** lbs./ft. Wall thickness or gauge No. **SDR 21**
 TYPE OF SCREEN OR PERFORATION MATERIAL:
 1 Steel 3 Stainless steel 5 Fiberglass 7 PVC 10 Asbestos-cement
 2 Brass 4 Galvanized steel 6 Concrete tile 8 RMP (SR) 11 Other (specify)
 12 None used (open hole)
 SCREEN OR PERFORATION OPENINGS ARE:
 1 Continuous slot 3 Mill slot 5 Gauzed wrapped 8 ~~Saw-cut~~ 11 None (open hole)
 2 Louvered shutter 4 Key punched 6 Wire wrapped 9 Drilled holes
 7 Torch cut 10 Other (specify)
 SCREEN-PERFORATED INTERVALS: From **100** ft. to **140** ft., From ft. to ft.
 From ft. to ft., From ft. to ft.
 GRAVEL PACK INTERVALS: From **13** ft. to **140** ft., From ft. to ft.
 From ft. to ft., From ft. to ft.

6 GROUT MATERIAL: 1 Neat cement 2 Cement grout 3 Bentonite 4 Other
 Grout Intervals: From **3** ft. to **13** ft., From ft. to ft., From ft. to ft.
 What is the nearest source of possible contamination:
 1 Septic tank 4 Lateral lines 7 Pit privy 10 Livestock pens 14 Abandoned water well
 2 Sewer lines 5 Cess pool 8 Sewage lagoon 11 Fuel storage 15 Oil well/Gas well
 3 Watertight sewer lines 6 Seepage pit 9 Feedyard 12 Fertilizer storage 16 Other (specify below)
 13 Insecticide storage **none**
 Direction from well? How many feet?

FROM	TO	LITHOLOGIC LOG	FROM	TO	LITHOLOGIC LOG
0	3	Surface			
3	20	Brown clay			
20	35	Caleche clay			
35	50	Medium sand and 60% brown clay			
50	80	Yellow and brown clay			
80	110	Sandy brown clay			
110	137	Medium fine sand and 20% clay			
137	140	Clay			

7 CONTRACTOR'S OR LANDOWNER'S CERTIFICATION: This water well was (1) constructed, (2) reconstructed, or (3) plugged under my jurisdiction and was completed on (mo/day/year) **5-8-85** and this record is true to the best of my knowledge and belief. Kansas Water Well Contractor's License No. **302** This Water Well Record was completed on (mo/day/yr) **5-10-87** under the business name of **Hodde Drilling Co.** by (signature) *Willie Zeller Jr*