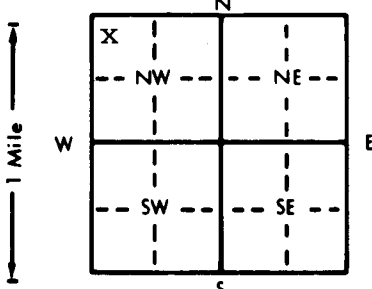


1 LOCATION OF WATER WELL: Fraction NW 1/4 NW 1/4 NW 1/4 Section Number 23 Township Number T 26 S Range Number R 24 E/W  
 County: Ford  
 Distance and direction from nearest town or city street address of well if located within city?

2 WATER WELL OWNER: Farmland Industries  
 RR#, St. Address, Box #: Box 1337 Board of Agriculture, Division of Water Resources  
 City, State, ZIP Code: Dodge City, Ks. 67801 Application Number: 919096

3 LOCATE WELL'S LOCATION WITH AN "X" IN SECTION BOX:  
  
 4 DEPTH OF COMPLETED WELL... 110 ft. ELEVATION:  
 Depth(s) Groundwater Encountered 1. .... ft. 2. .... ft. 3. .... ft.  
 WELL'S STATIC WATER LEVEL ... 65 ft. below land surface measured on mo/day/yr 11-26-93  
 Pump test data: Well water was ..... ft. after ..... hours pumping ..... gpm  
 Est. Yield ... 16 gpm: Well water was ..... ft. after ..... hours pumping ..... gpm  
 Bore Hole Diameter ... 10 in. to ... 110 ft., and ..... in. to ..... ft.  
 WELL WATER TO BE USED AS:  
 5 Public water supply 8 Air conditioning 11 Injection well  
 1 Domestic 3 Feedlot 6 Oil field water supply 9 Dewatering 12 Other (Specify below)  
 2 Irrigation 4 Industrial 7 Lawn and garden only 10 Monitoring well  
 Was a chemical/bacteriological sample submitted to Department? Yes.....No...X.....; If yes, mo/day/yr sample was submitted  
 Water Well Disinfected? Yes X No

5 TYPE OF BLANK CASING USED:  
 1 Steel 3 RMP (SR) 5 Wrought iron 8 Concrete tile CASING JOINTS: Glued X Clamped  
X PVC Sch.40 4 ABS flush joint 6 Asbestos-Cement 9 Other (specify below) Welded .....  
 7 Fiberglass Threaded.....  
 Blank casing diameter ... 5 in. to ... 110 ft., Dia ..... in. to ..... ft., Dia ..... in. to ..... ft.  
 Casing height above land surface ... 12 in., weight ..... lbs./ft. Wall thickness or gauge No. 200 psi.  
 TYPE OF SCREEN OR PERFORATION MATERIAL:  
 1 Steel 3 Stainless steel 5 Fiberglass X PVC Sch.40, flush joint 10 Asbestos-cement  
 2 Brass 4 Galvanized steel 6 Concrete tile 8 RMP (SR) joint 11 Other (specify) .....  
 12 None used (open hole)  
 SCREEN OR PERFORATION OPENINGS ARE:  
 5 Gauzed wrapped X Saw cut 11 None (open hole)  
 1 Continuous slot 3 Mill slot 6 Wire wrapped 9 Drilled holes  
 2 Louvered shutter 4 Key punched 7 Torch cut 10 Other (specify) .....  
 SCREEN-PERFORATED INTERVALS: From ... 70 ft. to ... 110 ft., From ..... ft. to ..... ft.  
 From ..... ft. to ..... ft., From ..... ft. to ..... ft.  
 GRAVEL PACK INTERVALS: From ... 65 ft. to ... 110 ft., From ..... ft. to ..... ft.  
Fine sand From 63 ft. to 65 ft., From ..... ft. to ..... ft.

6 GROUT MATERIAL: 1 Neat cement X Cement grout X Bentonite 4 Other .....  
 Grout Intervals: From ... 5 ft. to ... 60 ft., From ... 60 ft. to ... 63 ft., From ..... ft. to ..... ft.  
 What is the nearest source of possible contamination:  
 1 Septic tank 4 Lateral lines 7 Pit privy 10 Livestock pens 14 Abandoned water well  
 2 Sewer lines 5 Cess pool 8 Sewage lagoon 11 Fuel storage 15 Oil well/Gas well  
 3 Watertight sewer lines 6 Seepage pit 9 Feedyard 12 Fertilizer storage 16 Other (specify below)  
 13 Insecticide storage  
 Direction from well? How many feet?

FROM	TO	LITHOLOGIC LOG	FROM	TO	PLUGGING INTERVALS
0	2	Brown soil	90	95	fine sand
2	10	buff clay	95	97	gray sand & clay
10	14	brown clay	97	103	fine brown sand
14	18	white sticky caliche	103	108	sand containing clay
18	20	gray gritty hard drilling caliche	108	113	clay
20	33	gray gritty caliche	113	118	orange ochue
33	36	medium brown sand to gravel	118	120	gray shale
36	43	sand & gravel containing clay	120	122	reddish brown shale
43	55	gray clay (clay balls)			
55	63	brown clay			
63	73	gray caliche			
73	75	medium to coarse sand			
75	80	sand containing clay			
80	83	medium to very coarse sand			
83	90	medium gray sand			

7 CONTRACTOR'S OR LANDOWNER'S CERTIFICATION: This water well was (X constructed, (2) reconstructed, or (3) plugged under my jurisdiction and was completed on (mo/day/year) ... 12-7-93 ... and this record is true to the best of my knowledge and belief. Kansas Water Well Contractor's License No. .... 532 .... This Water Well Record was completed on (mo/day/yr) ... 12-27-93 ... under the business name of Midwest Well & Pump by (signature) Victor Jankup