


1 LOCATION OF WATER WELL: County: Ford Fraction: SW 1/4 NW 1/4 NW 1/4 Section Number: 23 Township Number: T 26 S Range Number: R 24 E(W)

Distance and direction from nearest town or city street address of well if located within city?

2 WATER WELL OWNER: Farmland Industries
 RR#, St. Address, Box #: Box 1337 Board of Agriculture, Division of Water Resources
 City, State, ZIP Code: Dodge City, Ks. 67801 Application Number: 919096

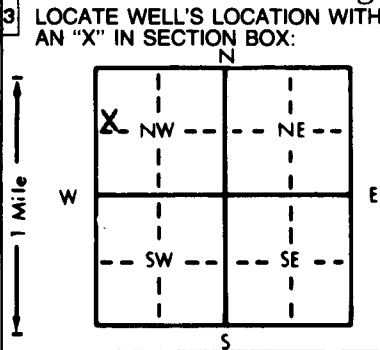

4 DEPTH OF COMPLETED WELL: 132 ft. ELEVATION:

Depth(s) Groundwater Encountered 1. ft. 2. ft. 3. ft.

WELL'S STATIC WATER LEVEL 74 ft. below land surface measured on mo/day/yr 11-26-93

Pump test data: Well water was ft. after hours pumping gpm

Est. Yield 15 gpm: Well water was ft. after hours pumping gpm

Bore Hole Diameter 10 in. to 132 ft., and in. to ft.

WELL WATER TO BE USED AS:

5 Public water supply	8 Air conditioning	11 Injection well
1 Domestic	3 Feedlot	6 Oil field water supply
2 Irrigation	4 Industrial	7 Lawn and garden only
		<input checked="" type="checkbox"/> 10 Monitoring well

12 Other (Specify below)

Was a chemical/bacteriological sample submitted to Department? Yes.....No.......... If yes, mo/day/yr sample was submitted

Water Well Disinfected? Yes No

5 TYPE OF BLANK CASING USED:

1 Steel	3 RMP (SR)	6 Asbestos-Cement	9 Other (specify below)
<input checked="" type="checkbox"/> PVC Sch.40	4 ABS flush joint	7 Fiberglass	

CASING JOINTS: Glued Clamped

Welded

Threaded

Blank casing diameter 5 in. to 132 ft., Dia in. to ft., Dia in. to ft.

Casing height above land surface 12 in., weight lbs./ft. Wall thickness or gauge No. 200 psi.

TYPE OF SCREEN OR PERFORATION MATERIAL:

1 Steel	3 Stainless steel	5 Fiberglass	8 RMP (SR)	10 Asbestos-cement
2 Brass	4 Galvanized steel	6 Concrete tile	9 ABS	11 Other (specify)
				12 None used (open hole)

SCREEN OR PERFORATION OPENINGS ARE:

1 Continuous slot	3 Mill slot	5 Gauzed wrapped	<input checked="" type="checkbox"/> Saw cut	11 None (open hole)
2 Louvered shutter	4 Key punched	6 Wire wrapped	9 Drilled holes	
		7 Torch cut	10 Other (specify)	

SCREEN-PERFORATED INTERVALS: From 82 ft. to 132 ft., From ft. to ft.

GRAVEL PACK INTERVALS: From 77 ft. to 132 ft., From ft. to ft.

Fine sand From 75 ft. to 77 ft., From ft. to ft.

6 GROUT MATERIAL: 1 Neat cement Cement grout Bentonite 4 Other

Grout Intervals: From 5 ft. to 75 ft., From 72 ft. to 75 ft., From ft. to ft.

What is the nearest source of possible contamination:

1 Septic tank	4 Lateral lines	7 Pit privy	10 Livestock pens	14 Abandoned water well
2 Sewer lines	5 Cess pool	8 Sewage lagoon	11 Fuel storage	15 Oil well/Gas well
3 Watertight sewer lines	6 Seepage pit	9 Feedyard	12 Fertilizer storage	16 Other (specify below)
			13 Insecticide storage	

Direction from well? How many feet?

FROM	TO	LITHOLOGIC LOG	FROM	TO	PLUGGING INTERVALS
0	3	black soil	118	120	medium sand containing clay
3	19	brown clay	120	127	sand & gravel containing clay
19	40	white caliche, containing greasy clay	127	133	weathered shale
40	55	white caliche	133	139	orange ochue
55	61	gray caliche	139	142	gray shale
61	65	fine brown sand			
65	68	sandy clay			
68	74	gray clay & caliche			
74	80	clay containing sand & gravel			
80	84	sandy brown clay			
84	86	sandy clay & caliche			
86	100	medium sand to fine gravel			
100	110	very fine sand			
110	115	fine to medium sand			
115	118	sandy clay			

7 CONTRACTOR'S OR LANDOWNER'S CERTIFICATION: This water well was constructed, (2) reconstructed, or (3) plugged under my jurisdiction and was completed on (mo/day/year) 12-7-93 and this record is true to the best of my knowledge and belief. Kansas Water Well Contractor's License No. 532 This Water Well Record was completed on (mo/day/yr) 12-27-93 under the business name of Midwest Well & Pump by (signature) Victor Sankup

INSTRUCTIONS: Use typewriter or ball point pen. PLEASE PRESS FIRMLY and PRINT clearly. Please fill in blanks, underline or circle the correct answers. Send top three copies to Kansas Department of Health and Environment, Bureau of Water, Topeka, Kansas 66620-0001. Telephone: 913-296-5545. Send one to WATER WELL OWNER and retain one for your records.