

USE TYPEWRITER OR BALL POINT PEN-PRESS FIRMLY, PRINT CLEARLY.

WATER WELL RECORD
KSA 82a-1201-1215


T7. DODGE

Kansas Department of Health and Environment-Division of Environment
(Water well Contractors)
Topeka, Kansas 66620

DAR
Well #3

1. Location of well: County **Ford** Fraction **NW 1/4 NE 1/4 SE 1/4** Section number **31** Township number **T 26 S R 24** Range number **5W**

2. Distance and direction from nearest town or city: **on Fort Dodge Road - 1/2 mile South of Kindsvater Truck Line**
3. Owner of well: **Andy Kindsvater**
R.R. or street: **106 Carefree Lane**
City, state, zip code: **Dodge City, Kansas 67801**

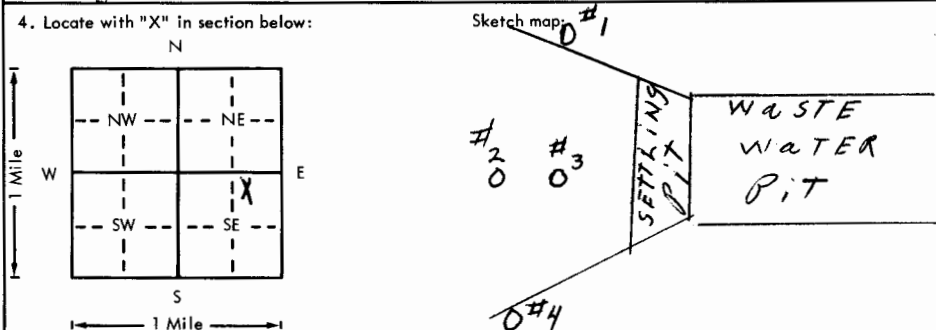

X Bore hole dia. **8** in. Completion date **6-17-77**
Well depth **165** ft.
7. Cable tool Rotary Driven Dug
 Hollow rod Jetted Bored Reverse rotary
8. Use: Domestic Public supply Industry
 Irrigation Air conditioning Stock
 Lawn Oil field water Other
9. Casing: Material **RMP** Height: Above **2500**
Threaded Welded Surface **12** in.
RMP PVC Weight lbs./ft.
Dia. **5** in. to **165** ft. depth Wall Thickness: inches or
Dia. in. to ft. depth gage No. **250**

5. Type and color of material	From	To
Topsoil & sandy (coarse)	0	15
Coarse sand & clay	15	45
Coarse sand & clay layers	45	75
Coarse sand & clay	75	105
Coarse sand	105	135
Coarse sand & clay	135	150
Coarse sand, clay & shale	150	165
<i>BRICK 160'</i>		
<i>25'</i>		
<i>135' sand thick</i>		
<i>100' A</i>		
<i>in of</i>		

10. Screen: Manufacturer's name **Sunflower**
Type **RMP** Dia. **5"**
Slot **3/32** **78"** Length **20 ft.**
Set between **140** ft. and **160** ft.
ft. and ft.
Gravel pack? YES Size range of material **1/2"**
11. Static water level: mo./day/yr.
25 ft. below land surface Date **6-17-77**
12. Pumping level below land surfaces:
0 ft. after **1 1/2** hrs. pumping **70** g.p.m.
 ft. after hrs. pumping g.p.m.
Estimated maximum yield **100** g.p.m.
13. Water sample submitted: Yes No Date
14. Well head completion: **NONE**
 Pitless adapter Inches above grade
15. Well grouted? YES
With: Neat cement Bentonite Concrete
Depth: From **0** ft. to **10** ft.
16. Nearest source of possible contamination: **truck wash**
ft. **60** Direction **east** Type **pit**
Well disinfected upon completion? YES No
17. Pump: Not installed
Manufacturer's name **Goulds**
Model number **UMT** HP **5** Volts **230**
Length of drop pipe **84** ft. capacity **45** g.p.m.
Type:
 Submersible Turbine
 Jet Reciprocating
 Centrifugal Other

18. Elevation: **TOP**
19. Remarks: **This well is used for a truck wash only**

20. Water well contractor's certification:
This well was drilled under my jurisdiction and this report is true to the best of my knowledge and belief.
Joe's Well Service 179
Business name License No.
Address **Box 174 Cimarron, Ks.**
Signed **Larry Crick** Date **10-5-77**
Authorized representative

260
 340
 31
 1/4 1/4 1/4
 NUENESE

2465
160
1305