


1 LOCATION OF WATER WELL: County: Ford Fraction:  $\frac{1}{4}$  E  $\frac{1}{4}$  SW  $\frac{1}{4}$  Section Number: 31 Township Number: T 26 S Range Number: R 24 EW

Distance and direction from nearest town or city street address of well if located within city?  
at Wastewater Trt. Facility @ 100 McCostland Rd. #1

2 WATER WELL OWNER: City of Dodge City, KS.  
 RR#, St. Address, Box #: City Hall, Box 886  
 City, State, ZIP Code: Dodge City, KS. 67801  
 Board of Agriculture, Division of Water Resources  
 Application Number: 36835

3 LOCATE WELL'S LOCATION WITH AN "X" IN SECTION BOX:  
 4 DEPTH OF COMPLETED WELL: 34.0 ft. ELEVATION: 68.8

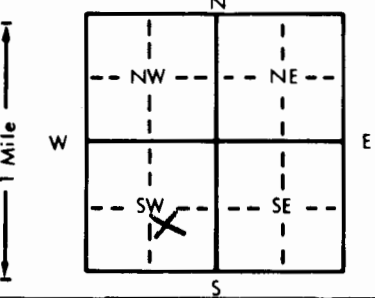

Depth(s) Groundwater Encountered 1. 15.0 ft. 2. .... ft. 3. .... ft.  
 WELL'S STATIC WATER LEVEL 14.9 ft. below land surface measured on mo/day/yr 11/3/83  
 Pump test data: Well water was .... ft. after .... hours pumping .... gpm  
 Est. Yield 250 gpm: Well water was .... ft. after .... hours pumping .... gpm  
 Bore Hole Diameter 30 in. to .... ft., and .... in. to .... ft.  
 WELL WATER TO BE USED AS:  
 5 Public water supply 8 Air conditioning 11 Injection well  
 1 Domestic 3 Feedlot 6 Oil field water supply 9 Dewatering 12 Other (Specify below)  
 2 Irrigation 4 Industrial 7 Lawn and garden only 10 Observation well  
 Was a chemical/bacteriological sample submitted to Department? Yes.....No...X.....; If yes, mo/day/yr sample was submitted  
 Water Well Disinfected? Yes No...X...

5 TYPE OF BLANK CASING USED:  
 1 Steel 2 PVC 3 RMP (SR) 4 ABS 5 Wrought iron 6 Asbestos-Cement 7 Fiberglass 8 Concrete tile 9 Other (specify below) CASING JOINTS: Glued .... Clamped ....  
 Welded X Threaded.....

Blank casing diameter .... 16.0 in. to 6.0 ft., Dia. .... in. to .... ft., Dia. .... in. to .... ft.  
 Casing height above land surface .... 18.0 in., weight .... 32.0 lbs./ft. Wall thickness or gauge No. 250"

TYPE OF SCREEN OR PERFORATION MATERIAL:  
1 Steel 2 Brass 3 Stainless steel 4 Galvanized steel 5 Fiberglass 6 Concrete tile 7 PVC 8 RMP (SR) 9 ABS 10 Asbestos-cement 11 Other (specify) ..... 12 None used (open hole)

SCREEN OR PERFORATION OPENINGS ARE:  
 1 Continuous slot 2 Louvered shutter 3 Mill slot 4 Key punched 5 Gauzed wrapped 6 Wire wrapped 7 Torch cut 8 Saw cut 9 Drilled holes 10 Other (specify) ..... 11 None (open hole)

SCREEN-PERFORATED INTERVALS: From 6.0 ft. to 34.0 ft., From .... ft. to .... ft.  
 GRAVEL PACK INTERVALS: From 4.0 ft. to 34.0 ft., From .... ft. to .... ft.

6 GROUT MATERIAL: 1 Neat cement 2 Cement grout 3 Bentonite 4 Other compacted clay  
 Grout Intervals: From 0.0 ft. to 4.0 ft., From .... ft. to .... ft., From .... ft. to .... ft.

What is the nearest source of possible contamination:  
 1 Septic tank 2 Sewer lines 3 Watertight sewer lines 4 Lateral lines 5 Cess pool 6 Seepage pit 7 Pit privy 8 Sewage lagoon 9 Feedyard 10 Livestock pens 11 Fuel storage 12 Fertilizer storage 13 Insecticide storage 14 Abandoned water well 15 Oil well/Gas well 16 Other (specify below)  
 Direction from well? North How many feet? 140'

FROM	TO	LITHOLOGIC LOG	FROM	TO	LITHOLOGIC LOG
0	3	top soil			
3	15	fine dry sand			
15	15.5	little soft clay			
15.5	20.0	coarse gravel & water			
20.0	22	coarse gravel & small boulders			
22	30	hard light gray clay			
30	34	fine dirty sandy clay			
34		total depth			

7 CONTRACTOR'S OR LANDOWNER'S CERTIFICATION: This water well was (1) constructed, (2) reconstructed, or (3) plugged under my jurisdiction and was completed on (mo/day/year) 11/31/83 and this record is true to the best of my knowledge and belief. Kansas Water Well Contractor's License No. 429 This Water Well Record was completed on (mo/day/yr) 12/28/83  
 under the business name of Subgrade Const Inc. by (signature) David Newson

INSTRUCTIONS: Use typewriter or ball point pen, PLEASE PRESS FIRMLY and PRINT clearly. Please fill in blanks, underline or circle the correct answers. Send top three copies to Kansas Department of Health and Environment, Division of Environment, Environmental Geology Section, Topeka, KS 66620. Send one to WATER WELL OWNER and retain one for your records.

OFFICE USE ONLY  
T  
R  
EW  
SEC.