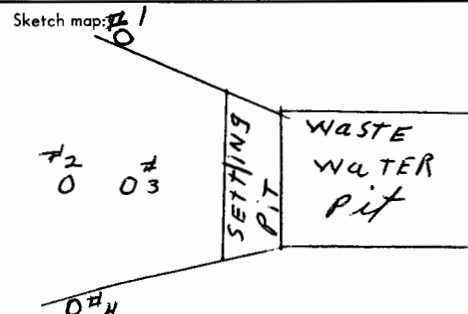


USE TYPEWRITER OR BALL POINT PEN-PRESS FIRMLY, PRINT CLEARLY.

WATER WELL RECORD
KSA 82a-1201-1215

Kansas Department of Health and Environment-Division of Environment
(Water well Contractors)
Topeka, Kansas 66620

DAB
Well #2

1. Location of well:		County Ford	Fraction NW 1/4 NE 1/4 SE 1/4	Section number 31	Township number T 26S	Range number S R 24	XE/W
2. Distance and direction from nearest town or city: Street address of well location if in city: on Fort Dodge Road - 3/4 mile South of Kindsvater Truck Line				3. Owner of well: Andy Kindsvater R.R. or street: 106 Carefree Lane City, state, zip code: Dodge City, Kansas 67801			
4. Locate with "X" in section below:		Sketch map: 			6. Bore hole dia. 8 in. Completion date _____ Well depth 165 ft. 6-15-77		
5. Type and color of material		From			To		
Coarse sandy topsoil		0			15		
Coarse sand & clay		15			45		
Coarse sand & clay layers		45			105		
Coarse sand		105			135		
Coarse sand & clay		135			150		
Coarse sand, clay & shale		150			165		
BRICK 160'							
25'							
135' set thick							
g							
(Use a second sheet if needed)							
7. Cable tool <input checked="" type="checkbox"/> Rotary _____ Driven _____ Dug _____ Hollow rod _____ Jetted _____ Bored _____ Reverse rotary _____		8. Use: Domestic _____ Public supply _____ Industry <input checked="" type="checkbox"/> Irrigation _____ Air conditioning _____ Stock _____ Lawn _____ Oil field water _____ Other _____					
9. Casing: Material RMP Height: Above ground _____ Threaded _____ Welded _____ Surface 12 in. RMP <input checked="" type="checkbox"/> PVC _____ Weight _____ lbs./ft. Dia. 5 in. to 163 ft. depth Wall Thickness: inches or _____ Dia. _____ in. to _____ ft. depth gage No. 250		10. Screen: Manufacturer's name Sunflower Type RMP Dia. 5" Slot xxx 1/8" Length 20 ft. Set between 140 ft. and 160 ft. _____ ft. and _____ ft. Gravel pack? <input checked="" type="checkbox"/> yes Size range of material 1/4"					
11. Static water level: _____ mo./day/yr. 25 ft. below land surface Date 6-15-77		12. Pumping level below land surfaces: 0 ft. after 1 1/2 hrs. pumping 70 g.p.m. _____ ft. after _____ hrs. pumping _____ g.p.m. Estimated maximum yield 100 g.p.m.					
13. Water sample submitted: _____ mo./day/yr. <input type="checkbox"/> Yes <input checked="" type="checkbox"/> No Date _____		14. Well head completion: None Pitless adapter _____ Inches above grade					
15. Well grouted? <input checked="" type="checkbox"/> yes With: <input checked="" type="checkbox"/> Neat cement _____ Bentonite _____ Concrete _____ Depth: From 0 ft. to 10 ft.		16. Nearest source of possible contamination: Truck wash ft. 60 Direction east Type pit Well disinfected upon completion? <input checked="" type="checkbox"/> Yes _____ No					
17. Pump: _____ Not installed Manufacturer's name Goulds Model number UMT HP 5 Volts 230 Length of drop pipe 84 ft. capacity 45 g.p.m. Type: <input checked="" type="checkbox"/> Submersible _____ Turbine _____ _____ Jet _____ Reciprocating _____ _____ Centrifugal _____ Other _____		18. Elevation: _____					
19. Remarks: This well is used for a cattle truck wash only 10PC		20. Water well contractor's certification: This well was drilled under my jurisdiction and this report is true to the best of my knowledge and belief. Joe's Well Service 179 Business name License No. Address Box 174 Cimarron, Ks. Signed Larry Crick Date 10-5-77 Authorized representative					

26
240
31
1/4 1/4 1/4
BUSINESS
Sec