

USE TYPEWRITER OR BALL POINT PEN-PRESS FIRMLY, PRINT CLEARLY.

WATER WELL RECORD  
KSA 82a-1201-1215

*H. Dodge*


Kansas State Dept. Of Health  
(Water Well Contractors)  
Forbes-Bldg. 740  
Topeka, Kansas 66620

Grand View

ADD

1 Location of well:	County <b>Ford</b>	Township name <del>#####</del> <i>Dodge</i>	Section <del>SE of NE</del>	Section number <b>31</b>	Town number <b>T-26-S</b>	Range number <b>R-24-W</b>
---------------------	-----------------------	---	--------------------------------	-----------------------------	------------------------------	-------------------------------

Distance and direction from nearest town or city: <b>Southeast edge of Dodge City</b> Street address of well location if in city:	3 Owner of well: <b>Kindswater Farms</b> Address: <b>Dodge City, Ks</b>
---	--

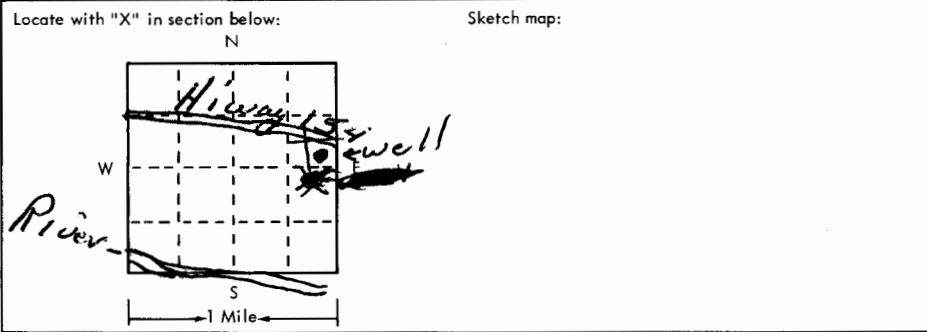

4 Well depth: <b>158</b> ft. Date of completion <b>4-7-75</b> Well diameter <b>28</b> in.
5 <input type="checkbox"/> Cable tool <input type="checkbox"/> Rotary <input type="checkbox"/> Driven <input type="checkbox"/> Dug <input type="checkbox"/> Hollow rod <input type="checkbox"/> Jetted <input type="checkbox"/> Bored <input checked="" type="checkbox"/> Reverse rotary
6 Use: <input type="checkbox"/> Domestic <input type="checkbox"/> Public supply <input type="checkbox"/> Industry <input checked="" type="checkbox"/> Irrigation <input type="checkbox"/> Air conditioning <input type="checkbox"/> Commercial <input type="checkbox"/> Test well
7 Casing: Material <b>Metal</b> Height: above/below Threaded <input type="checkbox"/> Welded <input checked="" type="checkbox"/> Surface <b>34</b> in. Diam. <b>30.30</b> lbs./ft. <b>16</b> in. to <b>158</b> ft. depth Drive shoe? <input type="checkbox"/> Yes <input checked="" type="checkbox"/> No

2	Type and color of material	From	To
	Surface	0	3
	Brown sandy clay	3	7
	Good sand and gravel	7	20
	Yellow clay	20	36
	Fine to med. sand and gravel	36	67
	Sandy yellow clay	67	76
	Good sand and gravel	76	90
	50% sand-50% clay	90	100
	A-1 sand & gravel	100	155
	Flat gravel with 10% clay mixed	155	160
	Gray clay	160	165
	50% fine sand-50% clay	165	170
	Black shale	170	180
	<i>Rock 160'</i> <i>16</i> <i>174' sat thick</i>		

(use a second sheet if needed)

8 Screen: Manufacturer <b>Free-Flo (W.A. Brown)</b> Type <b>10%</b> Dia. <b>16</b> Slot/gauze <b>1/8</b> Length <b>2"</b> Set between <b>98</b> ft. and <b>158</b> ft. Fittings: Gravel pack <input checked="" type="checkbox"/> Yes <input type="checkbox"/> No Size range of material <b>1/4</b>
9 Static water level: <b>16</b> ft. below land surface Date <b>4-7-75</b>
10 Pumping level below land surfaces: <b>45</b> ft. after <b>2</b> hrs. pumping <b>1221</b> g.p.m. <b>50</b> ft. after <b>2</b> hrs. pumping <b>1527</b> g.p.m. Estimated maximum yield <b>1800</b> g.p.m.
11 Water sample submitted: <input type="checkbox"/> Yes <input checked="" type="checkbox"/> No Date _____
12 Well head completion: <input type="checkbox"/> Pitless adapter <input checked="" type="checkbox"/> Inches above grade
13 Well grouted? <input checked="" type="checkbox"/> Yes <input type="checkbox"/> No <input checked="" type="checkbox"/> Neat cement <input type="checkbox"/> Bentonite <input type="checkbox"/> _____ Depth: From <b>0</b> ft. to <b>10</b> ft.
14 Nearest source of possible contamination: ft. _____ Direction <b>South</b> Type <b>Trk wash</b> Well disinfected upon completion? <input type="checkbox"/> Yes <input checked="" type="checkbox"/> No
15 Pump: <input type="checkbox"/> Not installed Manufacturer's name <b>Goulds</b> Model number <b>12JMO</b> HP <b>40</b> Volts <b>460</b> Length of drop pipe <b>120</b> ft. capacity <b>1200</b> g.p.m. Type: <input type="checkbox"/> Submersible <input checked="" type="checkbox"/> Turbine <input type="checkbox"/> Jet <input type="checkbox"/> Reciprocating <input type="checkbox"/> Centrifugal <input type="checkbox"/> Other

16 Remarks: elevation

Topography:  
 Hill  
 Slope  
 Upland  
 Valley

*70FO*

17 Water well contractor's certification:  
This well was drilled under my jurisdiction and this report is true to the best of my knowledge and belief.

**Ace-Hi Drilling Co 190**  
Business name **1442, Dodge City, Ks** License No. \_\_\_\_\_  
Address \_\_\_\_\_  
Signed *Paul G. Tittel* Date **5-7-75**  
Authorized representative