


LOCATION OF WATER WELL: County: **FORD** Fraction: **NE 1/4 SW 1/4 SE 1/4** Section Number: **31** Township Number: **T 26 S** Range Number: **R 24 EW**

Distance and direction from nearest town or city street address of well if located within city? **1/8 MILE SOUTH of City limits - McCaustland Rd. #2 DODGE CITY, KS**

WATER WELL OWNER: **K+T TRUCKING Co. McCaustland #2** Board of Agriculture, Division of Water Resources  
City, State, ZIP Code: **DODGE CITY, KS 67834** Application Number:

LOCATE WELL'S LOCATION WITH AN "X" IN SECTION BOX: DEPTH OF COMPLETED WELL: **151** ft. ELEVATION:

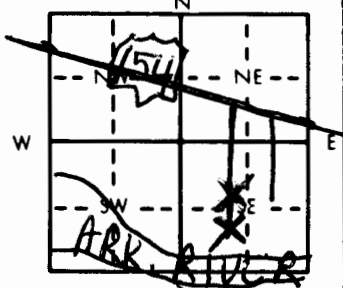

Depth(s) Groundwater Encountered 1. **8** ft. 2. **8** ft. 3. **8** ft.  
WELL'S STATIC WATER LEVEL **8** ft. below land surface measured on mo/day/yr **9-21-87**  
Pump test data: Well water was **8** ft. after **1** hours pumping **60** gpm  
Est. Yield **60** gpm: Well water was **8** ft. after **1** hours pumping **60** gpm  
Bore Hole Diameter **10** in. to **151** ft., and **10** in. to **151** ft.  
WELL WATER TO BE USED AS:  
1 Domestic 3 Feedlot 6 Oil field water supply 9 Dewatering **12 Other (Specify below)**  
2 Irrigation 4 Industrial 7 Lawn and garden only 10 Observation well **TRUCK WASH**  
Was a chemical/bacteriological sample submitted to Department? Yes **X** No **X**; If yes, mo/day/yr sample was submitted  
Water Well Disinfected? **Yes** No

TYPE OF BLANK CASING USED: 1 Steel 3 RMP (SR) 5 Wrought iron 8 Concrete tile CASING JOINTS: Glued Clamped  
2 PVC 4 ABS 6 Asbestos-Cement 9 Other (specify below) Welded  
7 Fiberglass Threaded

Casing height above land surface **20** in., weight **2.9** lbs./ft. Wall thickness or gauge No. **SDR-21**

TYPE OF SCREEN OR PERFORATION MATERIAL: 1 Steel 3 Stainless steel 5 Fiberglass 8 RMP (SR) 10 Asbestos-cement  
2 Brass 4 Galvanized steel 6 Concrete tile 9 ABS 12 None used (open hole)

SCREEN OR PERFORATION OPENINGS ARE: 1 Continuous slot 3 Mill slot 5 Gauzed wrapped 8 Saw cut 11 None (open hole)  
2 Louvered shutter 4 Key punched 6 Wire wrapped 9 Drilled holes  
7 Torch cut 10 Other (specify)


GROUT MATERIAL: 1 Neat cement 2 Cement grout 3 Bentonite 4 Other  

What is the nearest source of possible contamination:  
1 Septic tank 4 Lateral lines 7 Pit privy 11 Fuel storage 14 Abandoned water well  
2 Sewer lines 5 Cess pool 8 Sewage lagoon 12 Fertilizer storage 15 Oil well/Gas well  
3 Watertight sewer lines 6 Seepage pit 9 Feedyard 13 Insecticide storage 16 Other (specify below)

Direction from well? **100 ft SOUTH** How many feet? **100**

FROM	TO	LITHOLOGIC LOG	FROM	TO	LITHOLOGIC LOG
0	8	TOP SOIL + SAND			
8	151	SAND + GRAVEL			
151		SHALE			

CONTRACTOR'S OR LANDOWNER'S CERTIFICATION: This water well was (1) constructed, (2) reconstructed, or (3) plugged under my jurisdiction and was completed on (mo/day/year) **9-21-87** and this record is true to the best of my knowledge and belief. Kansas Water Well Contractor's License No. **217** This Water Well Record was completed on (mo/day/yr) **10-8-87**  
Under the business name of **BRAU DRILLING Co** by (signature) **[Signature]**

INSTRUCTIONS: Use typewriter or ball point pen, PLEASE PRESS FIRMLY and PRINT clearly. Please fill in blanks, underline or circle the correct answers. Send top three copies to Kansas Department of Health and Environment, Division of Environment, Environmental Geology Section, Topeka, KS 66620. Send one to WATER WELL OWNER and retain one for your records.

OFFICE USE ONLY  
T  
R  
EW  
SEC.  
1/4  
1/4  
1/4