USE TYPEWRITER OR BALL POINT PEN-PRESS FIRMLY, PRINT CLEARLY.

Ft. Dodge

WATER WELL RECORD
KSA 82a-1201-1215

Kansas Department of Health and Environment-Division of Environment
(Water well Contractors)
Topeka, Kansas 66620

1. Location of well:	County	Fraction	Section number	Township number	Range number
	Ford	NW 1/4 SE 1/4 NW 1/4	32	T 26 S	R 24 E/W

2. Distance and direction from nearest town or city: east out of Dodge City to 154 overpass, 1/8 North
Street address of well location if in city: 3/4 east, 75 yds. south

3. Owner of well: Farmland Industries
R.R. or street: RFD
City, state, zip code: Dodge City, Ks. 67801

4. Locate with "X" in section below:

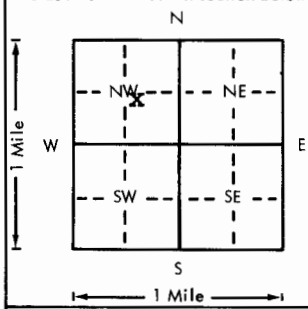

Sketch map:

6. Bore hole dia. 26 in. Completion date 11-30-76
Well depth 181 ft.

7. __ Cable tool __ Rotary __ Driven __ Dug
__ Hollow rod __ Jetted __ Bored X Reverse rotary

8. Use: __ Domestic __ Public supply __ Industry
X Irrigation __ Air conditioning __ Stock
__ Lawn __ Oil field water __ Other

9. Casing: Material Steel Height: Above ~~or below~~
Threaded ___ Welded X Surface 12 in.
RMP ___ PVC ___ Weight 36.87 lbs./ft.
Dia. 16 in. to 182 ft. depth Wall Thickness: inches or
Dia. ___ in. to ___ ft. depth gage No. ___

5. Type and color of material	From	To

10. Screen: Manufacturer's name Johnson
Type Galv. Dia. 16"
Slot/~~gauze~~ ___ Length 30 ft.
Set between 130 ft. and 160 ft.
Perf: 160-181 ft. and ___ ft.
Gravel pack? Yes Size range of material ½" down

11. Static water level: mo./day/yr.
86 ft. below land surface Date 9-3-76

12. Pumping level below land surfaces:
127 ft. after 2 hrs. pumping 800 g.p.m.
144 ft. after 4 hrs. pumping 1000 g.p.m.
Estimated maximum yield 1000 g.p.m.

13. Water sample submitted: mo./day/yr.
__ Yes X No Date ___

14. Well head completion:
__ Pitless adapter 12 Inches above grade

15. Well grouted? Yes
With: __ Neat cement __ Bentonite X Concrete
Depth: From 0 ft. to 10 ft.

16. Nearest source of possible contamination: N/A
ft. ___ Direction ___ Type ___
Well disinfected upon completion? ___ Yes X No

17. Pump: __ Not installed
Manufacturer's name Goulds - US Pump
Model number 10JHC HP 60 Volts ___
Length of drop pipe ___ ft. capacity 1000 g.p.m.
Type:
__ Submersible X Turbine
__ Jet __ Reciprocating
__ Centrifugal __ Other

(Use a second sheet if needed)

18. Elevation:

Topography:
__ Hill
X Slope
__ Upland
__ Valley

19. Remarks:

2486

20. Water well contractor's certification:
This well was drilled under my jurisdiction and this report is true to the best of my knowledge and belief.
Minter-Wilson Drlg. Co. 208
Business name License No.
Address Box A Garden City, Ks.
Authorized representative Date 3-23-77

T 26 R 24 (W) E Sec 32 1/4 1/4 1/4 NWSENW

Forward the white, blue and pink copies to the Department of Health and Environment

Form WWC-5