

USE TYPEWRITER OR BALL POINT PEN—PRESS FIRMLY, PRINT CLEARLY.

WATER WELL RECORD
KSA 82a-1201-1215

H. Dodge

T R EW sec 1/4 1/4 1/4 No.


Kansas State Dept. Of Health
(Water Well Contractors)
Forbes-Bldg. 740
Topeka, Kansas 66620

ACD

1 Location of well:	County Ford	Township name Grandview	Fraction SE SW NE NE SE	Section number 32	Town number 26	Range number 24
---------------------	-----------------------	-----------------------------------	---	-----------------------------	--------------------------	---------------------------

Distance and direction from nearest town or city:
1 mile east of Dodge City
Street address of well location if in city:

3 Owner of well: **Rodger Polkinghorn**
Address: **Ft. Dodge Road**

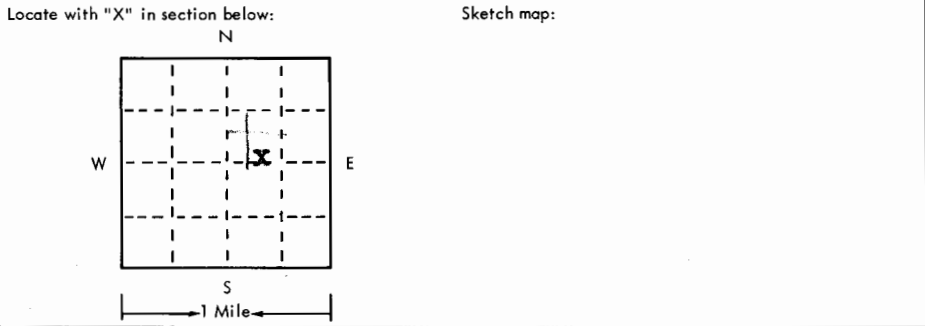

4 Well depth: **150** ft. Date of completion **5-20-75**
Well diameter **5** in.

5 Cable tool Rotary Driven Dug
 Hollow rod Jetted Bored Reverse rotary

6 Use: Domestic Public supply Industry
 Irrigation Air conditioning Commercial
 Test well _____

7 Casing: **plastic** Height: above/below
Threaded Welded Surface **12** in.
Diam. _____ Weight **1.8** lbs./ft. _____
5 in. to _____ ft. depth Drive shoe? Yes No
_____ in. to _____ ft. depth!

2	Type and color of material	From	To
	Surface	0	3
	Dark Clay	3	10
	Good Course sand and gravel	10	27
	Sand and clay layers	27	35
	Yellow clay	35	43
	Fine sand and clay layers	43	65
	Yellow clay little fine sand 20%	65	85
	A-1 bottom sand and gravel	85	150
	BRock 150'		
	15'		
	135' soil thickness		
	run of		

8 Screen: **20' screen**
Manufacturer **superior**
Type **15%** Dia. **5"**
Slot/gauze **1/16** Length **4"**
Set between **30** ft. and **150** ft. _____
Fittings:
Gravel pack Yes No Size range of material **7/8**

9 Static water level:
15 ft. below land surface Date **5-20-75**

10 Pumping level below land surfaces:
17 ft. after **2** hrs. pumping **20** g.p.m.
_____ ft. after _____ hrs. pumping _____ g.p.m.
Estimated maximum yield **20** g.p.m.

11 Water sample submitted:
 Yes No Date _____

12 Well head completion:
 Pitless adapter **12** Inches above grade

13 Well grouted? Yes No
 Neat cement Bentonite _____
Depth: From **3** ft. to **13** ft.

14 Nearest source of possible contamination:
ft **nc** Direction _____ Type _____
Well disinfected upon completion? Yes No

15 Pump **Reda** Not installed
Manufacturer's name **Reda Pump Co.**
Model number **19A18p201** HP **2** Volts **220**
Length of drop pipe **80** ft. capacity **20** g.p.m.
Type:
 Submersible Turbine
 Jet Reciprocating
 Centrifugal Other

16 Remarks: elevation

Topography:
 Hill
 Slope
 Upland
 Valley

TOP

17 Water well contractor's certification:
This well was drilled under my jurisdiction and this report is true to the best of my knowledge and belief.

Ace-Hi Drilling Co. 190
Business name License No. _____
Address **Box 1442 Dodge City KS**
Signed **Carl G. Stille** Date **6-7-75**
Authorized representative

2473

150