

USE TYPEWRITER OR BALL POINT PEN-PRESS FIRMLY, PRINT CLEARLY.


WATER WELL RECORD
KSA 82a-1201-1215

H.H. Dodge

Kansas Department of Health and Environment-Division of Environment (Water well Contractors) Topeka, Kansas 66620

1. Location of well: County Fo rd Fraction SE 1/4 SW 1/4 Section number 32 Township number T 26 Range number S R 24 E/W

2. Distance and direction from nearest town or city: Within east city limits Highway 54 3. Owner of well: Emory Randel
Street address of well location if in city: Ft. Dodge Road R.R. or street:
City, state, zip code: Dodge City, Ks 67801

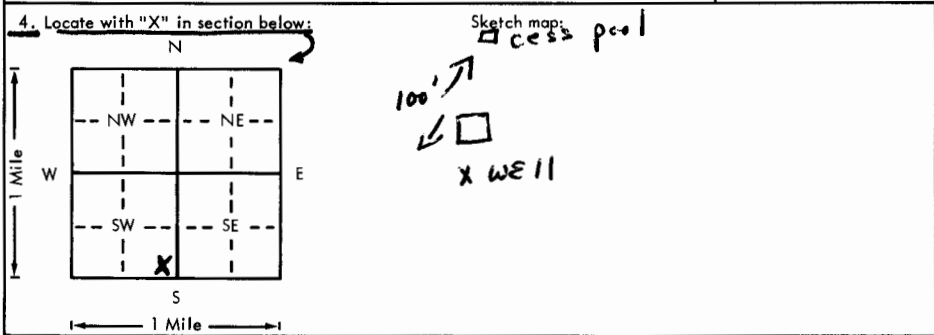

6. Bore hole dia. 8 in. Completion date _____
Well depth 150 ft. 6-23-78
7. Cable tool Rotary Driven Dug
 Hollow rod Jetted Bored Reverse rotary
8. Use: Domestic Public supply Industry
 Irrigation Air conditioning Stock
 Lawn Oil field water Other
9. Casing: Material Plastic Weight: Above or below
Threaded _____ Welded _____ Surface 18 in.
RMP _____ PVC glue Weight _____ lbs./ft.
Dia. 5 in. to 120 ft. depth Wall Thickness: inches or
Dia. _____ in. to _____ ft. depth gauge No. 250

5. Type and color of material	From	To
Topsoil	0	3
Clay	3	30
Sandy clay	30	105
105- Gravel	105	150
<i>100' cess pool</i>		
<i>100' sand truck</i>		
<i>(Use a second sheet if needed)</i>		

10. Screen: Manufacturer's name Jess & Lowell
Type Plastic Dia. 5"
Slot gauge 1/16 Length 30"
Set between 120 ft. and 150 ft.
ft. and _____ ft.
Gravel pack? yes Size range of material 1/4
11. Static water level: _____ mo./day/yr.
30 ft. below land surface Date 6-23-
12. Pumping level below land surfaces: N/A
____ ft. after _____ hrs. pumping _____ g.p.m.
____ ft. after _____ hrs. pumping _____ g.p.m.
Estimated maximum yield _____ g.p.m.
13. Water sample submitted: _____ mo./day/yr.
Yes No Date _____
14. Well head completion:
 Pitless adapter 18 inches above grade
15. Well grouted? yes
With: Neat cement Bentonite Concrete
Depth: From 0 ft. to 20 ft.
16. Nearest source of possible contamination:
ft. 100 Direction N Type cesspool
Well disinfected upon completion? Yes No
17. Pump: _____ Not installed
Manufacturer's name Dempster
Model number HF315052 HP 1 1/2 Volts _____
Length of drop pipe 105 ft. capacity _____ g.p.m.
Type:
 Submersible Turbine
 Jet Reciprocating
 Centrifugal Other

18. Elevation: Level
Topography:
 Hill
 Slope
 Upland
 Valley

19. Remarks: 1000

20. Water well contractor's certification:
This well was drilled under my jurisdiction and this report is true to the best of my knowledge and belief.
Cragg Well Drilling 111
Business name License No. _____
Address 1308 So Second Dodge City, Ks
Signed Mark Cragg Date 6-23-78
Authorized representative
Ray Dugg Form WWC-5

Forward the white, blue and pink copies to the Department of Health and Environment

26 340 32 5/16 5/8 1/4

2460
150
2310