

USE TYPEWRITER OR BALL POINT PEN-PRESS FIRMLY, PRINT CLEARLY.

T R EW sec 1/4 1/4 1/4 No.

WATER WELL RECORD  
KSA 82a-1201-1215


Fl.  
Dodge

Kansas State Dept. Of Health  
(Water Well Contractors)  
Forbes-Bldg. 740  
Topeka, Kansas 66620

DDD

1 Location of well:	County <b>FORD</b>	Township name <b>GRAND View</b>	Fraction <b>SE 1/4 SE 1/4 SE 1/4</b>	Section number <b>32</b>	Town number <b>26</b>	Range number <b>24</b>
---------------------	-----------------------	------------------------------------	---	-----------------------------	--------------------------	---------------------------

Distance and direction from nearest town or city: <b>1 m E of Dodge</b>	3 Owner of well: <b>J. E. Homan</b>
Street address of well location if in city:	Address: <b>Ra Dodge City ks</b>

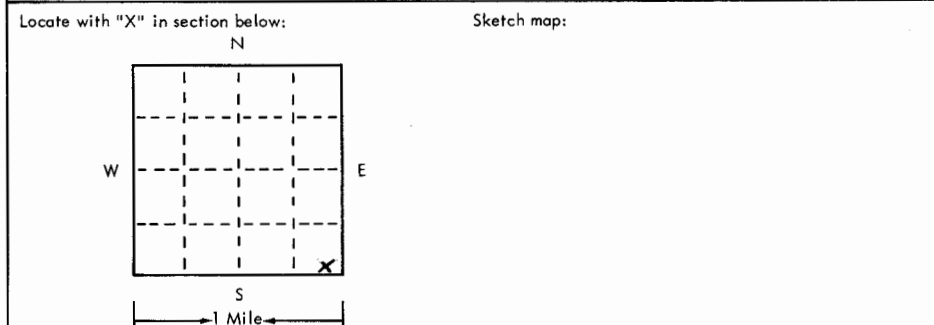

4 Well depth: <b>150</b> ft. Date of completion: <b>2/17/75</b> Well diameter: <b>5</b> in.
5 <input type="checkbox"/> Cable tool <input checked="" type="checkbox"/> Rotary <input type="checkbox"/> Driven <input type="checkbox"/> Dug <input type="checkbox"/> Hollow rod <input type="checkbox"/> Jetted <input type="checkbox"/> Bored <input type="checkbox"/> Reverse rotary
6 Use: <input checked="" type="checkbox"/> Domestic <input type="checkbox"/> Public supply <input type="checkbox"/> Industry <input type="checkbox"/> Irrigation <input type="checkbox"/> Air conditioning <input type="checkbox"/> Commercial <input type="checkbox"/> Test well
7 Casing: Material <b>PVC</b> Height: <b>above</b> /below Threaded <input type="checkbox"/> Welded <input type="checkbox"/> Surface <b>20</b> in. Diam. <b>5</b> in. Weight <b>25</b> lb./ft. W.P. <b>5</b> in. to <b>150</b> ft. depth Drive shoe? <input type="checkbox"/> Yes <input checked="" type="checkbox"/> No

2	Type and color of material	From	To
	Soil	0	2
	SAND	2	16
	GRAVEL	16	24
	CLAY	24	60
	GRAVEL	60	64
	CLAY	64	111
	GRAVEL	111	150
	ROCK 150'		
	32 718' sat 4 1/2'		

8 Screen: Manufacturer <b>less &amp; lower</b> Type <b>PVC</b> Dia. <b>5</b> Slot/gauze <b>1/16</b> Length <b>3</b> Set between <b>120</b> ft. and <b>150</b> ft. Fittings: Gravel pack <input checked="" type="checkbox"/> Yes <input type="checkbox"/> No Size range of material <b>1/8</b>
9 Static water level: <b>32</b> ft. below land surface Date <b>12/17/75</b>
10 Pumping level below land surfaces: <b>N/A</b> ____ ft. after ____ hrs. pumping ____ g.p.m. ____ ft. after ____ hrs. pumping ____ g.p.m. Estimated maximum yield ____ g.p.m.

11 Water sample submitted: <input type="checkbox"/> Yes <input checked="" type="checkbox"/> No Date _____
12 Well head completion: <input checked="" type="checkbox"/> Pitless adapter <b>20</b> inches above grade
13 Well grouted? <input checked="" type="checkbox"/> Yes <input type="checkbox"/> No <input checked="" type="checkbox"/> Neat cement <input type="checkbox"/> Bentonite Depth: From <b>3</b> ft. to <b>13</b> ft.
14 Nearest source of possible contamination: ft. <b>100</b> Direction <b>west</b> Type <b>seepage</b> Well disinfected upon completion? <input type="checkbox"/> Yes <input type="checkbox"/> No
15 Pump: <input type="checkbox"/> Not installed Manufacturer's name <b>Reo A</b> Model number <b>101840</b> HP <b>1hp</b> Volts <b>220</b> Length of drop pipe <b>84</b> ft. capacity <b>1200</b> g.p.m. Type: <input checked="" type="checkbox"/> Submersible <input type="checkbox"/> Turbine <input type="checkbox"/> Jet <input type="checkbox"/> Reciprocating <input type="checkbox"/> Centrifugal <input type="checkbox"/> Other

16 Remarks: elevation

Topography:  
 Hill  Slope **Level**  
 Upland  Valley

1070

17 Water well contractor's certification:  
This well was drilled under my jurisdiction and this report is true to the best of my knowledge and belief.  
**CRAGG WELL DRILLING 111**  
Business name License No.  
Address **211 Dodge City ks**  
Signed **[Signature]** Date **2/17/75**  
Authorized representative