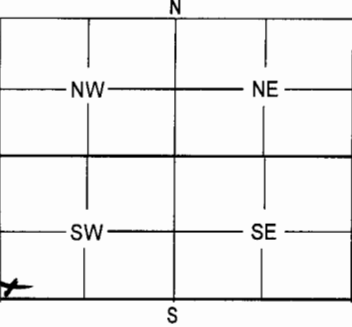


1	LOCATION OF WATER WELL:	Fraction	Section Number	Township Number	Range Number
	County: Ford	SW ¹⁴ SW ¹⁴	25	26	24

Distance and direction from nearest town or city street address of well if located within city?

RSA Microtech, Dodge City, KS


2	WATER WELL OWNER: RSA Microtech	Board of Agriculture, Division of Water Resources
	RR #, St. Address, Box # 510 East Trail	Application Number:
	City, State, ZIP Code Dodge City, 67801	

3	MARK WELL'S LOCATION WITH AN "X" IN SECTION BOX:	4	DEPTH OF WELL 33.1 ft.
			WELL'S STATIC WATER LEVEL 999 ft.
			WELL WAS USED AS:
			1 Domestic 5 Public Water Supply 9 Dewatering 2 Irrigation 6 Oil Field Water Supply 10 Monitoring Well 3 Feedlot 7 Domestic (Lawn & Garden) 11 Injection Well 4 Industrial 8 Air Conditioning 12 Other
			Was a chemical / bacteriological sample submitted to Department? Yes _____ No <input checked="" type="checkbox"/>
			if yes, mo/day/yr sample was submitted _____
			Water Well Disinfected: Yes _____ No <input checked="" type="checkbox"/>

5	TYPE OF BLANK CASING USED:
	1 Steel 3 RMP (SR) 5 Wrought 7 Fiberglass 9 Other (Specify below) <input checked="" type="checkbox"/> 2 PVC 4 ABS 6 Asbestos-Cement 8 Concrete Tile
	Blank casing diameter 26 in. Was casing pulled? Yes <input checked="" type="checkbox"/> No _____ If yes, how much All
	Casing height above or below land surface _____ in.

6	GROUT PLUG MATERIAL: 1 Neat cement 2 Cement grout <input checked="" type="checkbox"/> 3 Bentonite 4 Other
	Grout Plug Intervals: From 33.1 ft. to 0 ft., From _____ ft. to _____ ft., From _____ ft. to _____ ft.
	What is the nearest source of possible contamination:
	1 Septic tank 6 Seepage pit 11 Fuel storage 16 Other (specify below) 2 Sewer lines 7 Pit privy 12 Fertilizer storage 3 Watertight sewer lines 8 Sewage lagoon 13 Insecticide storage 4 Lateral lines 9 Feedyard 14 Abandoned water well 5 Cess pool 10 Livestock pens 15 Oil well/Gas well
	Direction from well? 999 How many feet? 999

FROM	TO	PLUGGING MATERIALS
33.1	0	3/8 Bentonite chips

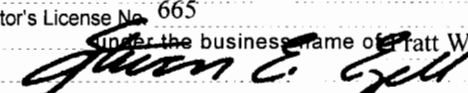7	CONTRACTOR'S OF LANDOWNER'S CERTIFICATION: This water well was plugged under my jurisdiction and was completed on (mo/day/year) 7-26-06 and this record is true to the best of my knowledge and belief. Kansas Water Well Contractor's License No. 665 This Water Well Record was completed on (mo/day/year) 8-30-06
	by (signature)  under the business name of Patti Well Environmental

INSTRUCTIONS: Use typewriter or ball point pen. Please press firmly and print clearly. Please fill in blanks, underline or circle the correct answers. Send top three copies to Kansas Department of Health and Environment, Bureau of Water, Geology Section, 1 000 SW Jackson St., Ste. 420, Topeka, Kansas 66612-1367. Telephone: 785/296-5522. Send one to Water Well Owner and retain one for your records.