


WATER WELL RECORD Form WWC-5 KSA 82a-1212

1 LOCATION OF WATER WELL: Fraction Section Number Township Number Range Number  
 COUNTY: FORD NW 1/4 NE 1/4 SE 1/4 31 T 26 S R 24 W

Distance and direction from nearest town or city street address of well if located within city?  
 ON FORT DODGE RD. - 1/2 SOUTH OF KINDSVATER TRUCK LINES

2 WATER WELL OWNER: MID AMERICA WASHOUT *Well # 2*  
 RR#, St. Address, Box #: 321 E. CATHY Board of Agriculture, Division of Water Resources  
 City, State, ZIP code: FREMONT, NE 68025- Application Number:

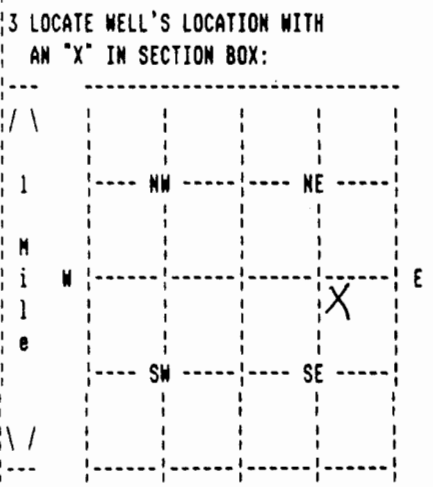

4 DEPTH OF COMPLETED WELL 160 ELEVATION: 0  
 Depth(s) Groundwater Encountered 1. 0 ft. 2. 0 ft. 3. 0 ft.  
 WELL'S STATIC WATER LEVEL 0 ft. below land surface measured on mo/day/yr / /  
 Pump testdata: Well water was 0 ft. after 0 hours pumping 0 gpm  
 Estimated Yield 0 gpm: Well water was 0 ft. after 0 hours pumping 0 gpm  
 Bore Hole Diameter 8 in. to 160 ft., and in. to 0 ft.  
 WELL WATER WAS: INDUSTRY  
 Was a chemical/bacteriological sample submitted to department? No ;  
 If yes, mo/day/yr sample was submitted Water well disinfected? Yes

5 TYPE OF BLANK CASING USED: RMP (SR) CASING JOINTS: GLUED  
 Blank casing diameter 5 in. to 160 ft., Dia in. to 0 ft., Dia in. to 0 ft.  
 Casing height above land surface 0 in., weight 0 lbs/ft. Wall thickness or gauge No.  
 TYPE OF SCREEN OR PERFORATION MATERIAL:  
 SCREEN OR PERFORATION OPENINGS ARE:

SCREEN PERFORATED INTERVALS: From 0 ft. to 0 ft., From 0 ft. to 0 ft.  
 From 0 ft. to 0 ft., From 0 ft. to 0 ft.  
 GRAVEL PACK INTERVALS: From 0 ft. to 4 ft., From 0 ft. to 0 ft.  
 From 0 ft. to 0 ft., From 0 ft. to 0 ft.

6 GROUT MATERIAL BENTONITE  
 Grout Intervals: From 4 ft. to 160 ft., From 0 ft. to 0 ft., From 0 ft. to 0 ft.  
 What is the nearest source of possible contamination: SEWAGE LAGOON  
 Direction from well? How many feet? 0

FROM	TO	LITHOLOGIC LOG	FROM	TO	PLUGGING INTERVALS
			0	4	COMPACTED DIRT & CLAY
			4	160	BENTONITE GROUT
			0	0	
			0	0	
			0	0	
			0	0	
			0	0	
			0	0	
			0	0	
			0	0	

7 CONTRACTOR'S OR LANDOWNER'S CERTIFICATION: This water well was Plugged under my jurisdiction and was completed on (mo/day/year) 09/29/09 and this record is true to the best of my knowledge and belief. Kansas Water Well Contractor's License No. 179 This Water Well Record was completed on (mo/day/yr) 10/19/09 under the business name of JOE'S WELL SERVICE, INC. by (signature) *Justin Crick*