

County: Ford Fraction: SW NW SE SW Sec. 33 T. 26 S R. 24 W

**CORRECTION(S) to WATER WELL COMPLETION RECORD Form WWC-5 (to rectify lacking or incorrect information)**

Owner: Cargill Meat Solutions M-18

If location corrected, was listed as:

Section-Township-Range: 3-27-24W

Fraction (¼ calls): NE SE NW

Location changed to:

33-26-24W

SW NW SE SW

Other changes: Initial statements: Latitude 37 degrees 44' 18" Longitude 99 degrees 57' 21"

Changed to: Lat 37.738333 Long-99.955833 NAD83

Comments: \_\_\_\_\_

Verification method: Used KGS LEOWEB to convert lat/long, KGS mapper speaking with Pam Chaffee and email from Cargill.

Initials: SH Date: 03-01-2022


Submitted by:  Kansas Geological Survey, Data Resources Library, 1930 Constant Ave., Lawrence, KS 66047-3724  
 Kansas Dept. of Health & Environment, Bureau of Water, 1000 SW Jackson, Suite 420, Topeka, KS 66612-1367

M18

1	LOCATION OF WATER WELL:	Fraction	Section Number	Township Number	Range Number
	County: FORD	NE 1/4 SE 1/4 NW 1/4	3	24 S	24

Distance and direction from nearest town or city street address of well if located within city?  
 1510' SW of Dodge Rd / Hwy 400 37044' 18" 99° 57' 21" (BW)

2	WATER WELL OWNER: CARGILL MEAT SOLUTIONS	Board of Agriculture, Division of Water Resources
	E. HWY 400	Application Number:
	RR #, St. Address, Box #: DODGE CITY, KS	

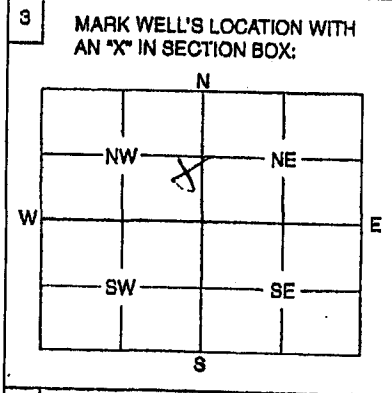

4 DEPTH OF WELL ..... 31 ..... ft.

WELL'S STATIC WATER LEVEL ..... ft.

WELL WAS USED AS:

1 Domestic	5 Public Water Supply	9 Dewatering
2 Irrigation	6 Oil Field Water Supply	x 10 Monitoring Well
3 Feedlot	7 Domestic (Lawn & Garden)	11 Injection Well
4 Industrial	8 Air Conditioning	12 Other .....

Was a chemical / bacteriological sample submitted to Department? Yes ..... No .....

If yes, mo/day/yr sample was submitted .....

Water Well Disinfected: Yes ..... No .....

6 TYPE OF BLANK CASING USED:

1 Steel	3 RMP (SR)	5 Wrought	7 Fiberglass	9 Other (Specify below)
x 2 PVC	4 ABS	6 Asbestos-Cement	8 Concrete Tile	

Blank casing diameter ..... 4 ..... in. Was casing pulled? Yes ..... No ..... If yes, how much .....

Casing height above or below land surface ..... in.

6 GROUT PLUG MATERIAL: 1 Neat cement 2 Cement grout 3 Bentonite 4 Other BENTONITE GROUT

Grout Plug Intervals: From 31 ft. to 0 ft., From ..... ft. to ..... ft., From ..... ft. to ..... ft.

What is the nearest source of possible contamination:

1 Septic tank	6 Seepage pit	11 Fuel storage	16 Other (specify below)
2 Sewer lines	7 Pit privy	12 Fertilizer storage	
3 Watertight sewer lines	8 Sewage lagoon	13 Insecticide storage	
4 Lateral lines	9 Feedyard	14 Abandoned water well	
5 Cess pool	10 Livestock pens	15 Oil well/Gas well	

Direction from well? ..... How many feet? .....

FROM	TO	PLUGGING MATERIALS
31	0	BENTONITE GROUT

7 CONTRACTOR'S OF LANDOWNER'S CERTIFICATION: This water well was plugged under my jurisdiction and was completed on (mo/day/year) 8/28/10 and this record is true to the best of my knowledge and belief. Kansas Water Well Contractor's License No. 102 This Water Well Record was completed on (mo/day/year) 8/28/10 under the business name of LAYNE CHRISTENSEN COMPANY by (signature) [Signature]

INSTRUCTIONS: Use typewriter or ball point pen. Please press firmly and print clearly. Please fill in blanks, underline or circle the correct answers. Send top three copies to Kansas Department of Health and Environment, Bureau of Water, Geology Section, 1000 SW Jackson St., Ste. 420, Topeka, Kansas 66612-1367. Telephone: 785/296-5522. Send one to Water Well Owner and retain one for your records.