


East Irrigation Well

1 LOCATION OF WATER WELL: Fraction NW 1/4, SE 1/4 SE 1/4 Section Number 32 Township Number 26 5 Range Number 24 (EW)
 County: Ford

Distance and direction from nearest town or city street address of well if located within city? 1.5 miles east of Dodge City on 54 Hwy N 37° 44.371
W 99° 57.956

2 WATER WELL OWNER: Cargill
 RR #, St. Address, Box #: 3201 E. Trail P.O. Box 1060
 City, State, ZIP Code: Dodge City KS 67801 Board of Agriculture, Division of Water Resources
 Application Number: _____

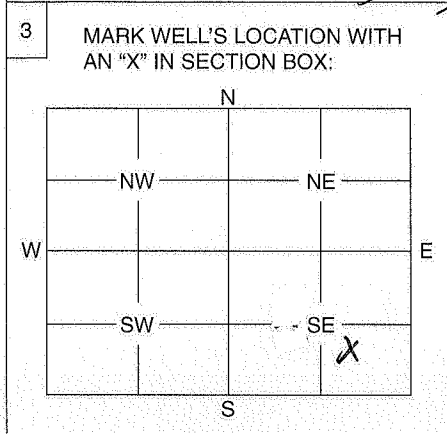

4 DEPTH OF WELL 144 ft.
 WELL'S STATIC WATER LEVEL 55 ft.
 WELL WAS USED AS:
 1 Domestic 5 Public Water Supply 9 Dewatering
 2 Irrigation 6 Oil Field Water Supply 10 Monitoring Well
 3 Feedlot 7 Domestic (Lawn & Garden) 11 Injection Well
 4 Industrial 8 Air Conditioning 12 Other
 Was a chemical / bacteriological sample submitted to Department? Yes No
 If yes, mo/day/yr sample was submitted
 Water Well Disinfected: Yes No


5 TYPE OF BLANK CASING USED:
 Steel ^{Galvanized?} 3 RMP (SR) 5 Wrought 7 Fiberglass 9 Other (Specify below)
 2 PVC 4 ABS 6 Asbestos-Cement 8 Concrete Tile
 Blank casing diameter 14 in. Was casing pulled? Yes No If yes, how much 4'
 Casing height above or below land surface 48 in.

6 GROUT PLUG MATERIAL: 1 Neat cement Cement grout 3 Bentonite 4 Other
 Grout Plug Intervals: From 24 ft. to 4 ft., From ft. to ft., From to ft.
 What is the nearest source of possible contamination:
 1 Septic tank 6 Seepage pit 11 Fuel storage Other (specify below)
 2 Sewer lines 7 Pit privy 12 Fertilizer storage None
 3 Watertight sewer lines 8 Sewage lagoon 13 Insecticide storage Known
 4 Lateral lines 9 Feedyard 14 Abandoned water well
 5 Cess pool 10 Livestock pens 15 Oil well/Gas well
 Direction from well? How many feet?

FROM	TO	PLUGGING MATERIALS
<u>144</u>	<u>24</u>	<u>Chlorinated Gravel</u>
<u>24</u>	<u>4</u>	<u>Cement Grout</u>
<u>4</u>	<u>0</u>	<u>Top Soil</u>

7 CONTRACTOR'S OF LANDOWNER'S CERTIFICATION: This water well was plugged under my jurisdiction and was completed on (mo/day/year) 8/15/11 and this record is true to the best of my knowledge and belief. Kansas Water Well Contractor's License No. 102 This Water Well Record was completed on (mo/day/year) under the business name of Layne Christensen Company by (signature) [Signature]

INSTRUCTIONS: Use typewriter or ball point pen. Please press firmly and print clearly. Please fill in blanks, underline or circle the correct answers. Send top three copies to Kansas Department of Health and Environment, Bureau of Water, Geology Section, 1000 SW Jackson St., Ste. 420, Topeka, Kansas 66612-1367. Telephone: 785/296-5522. Send one to Water Well Owner and retain one for your records.

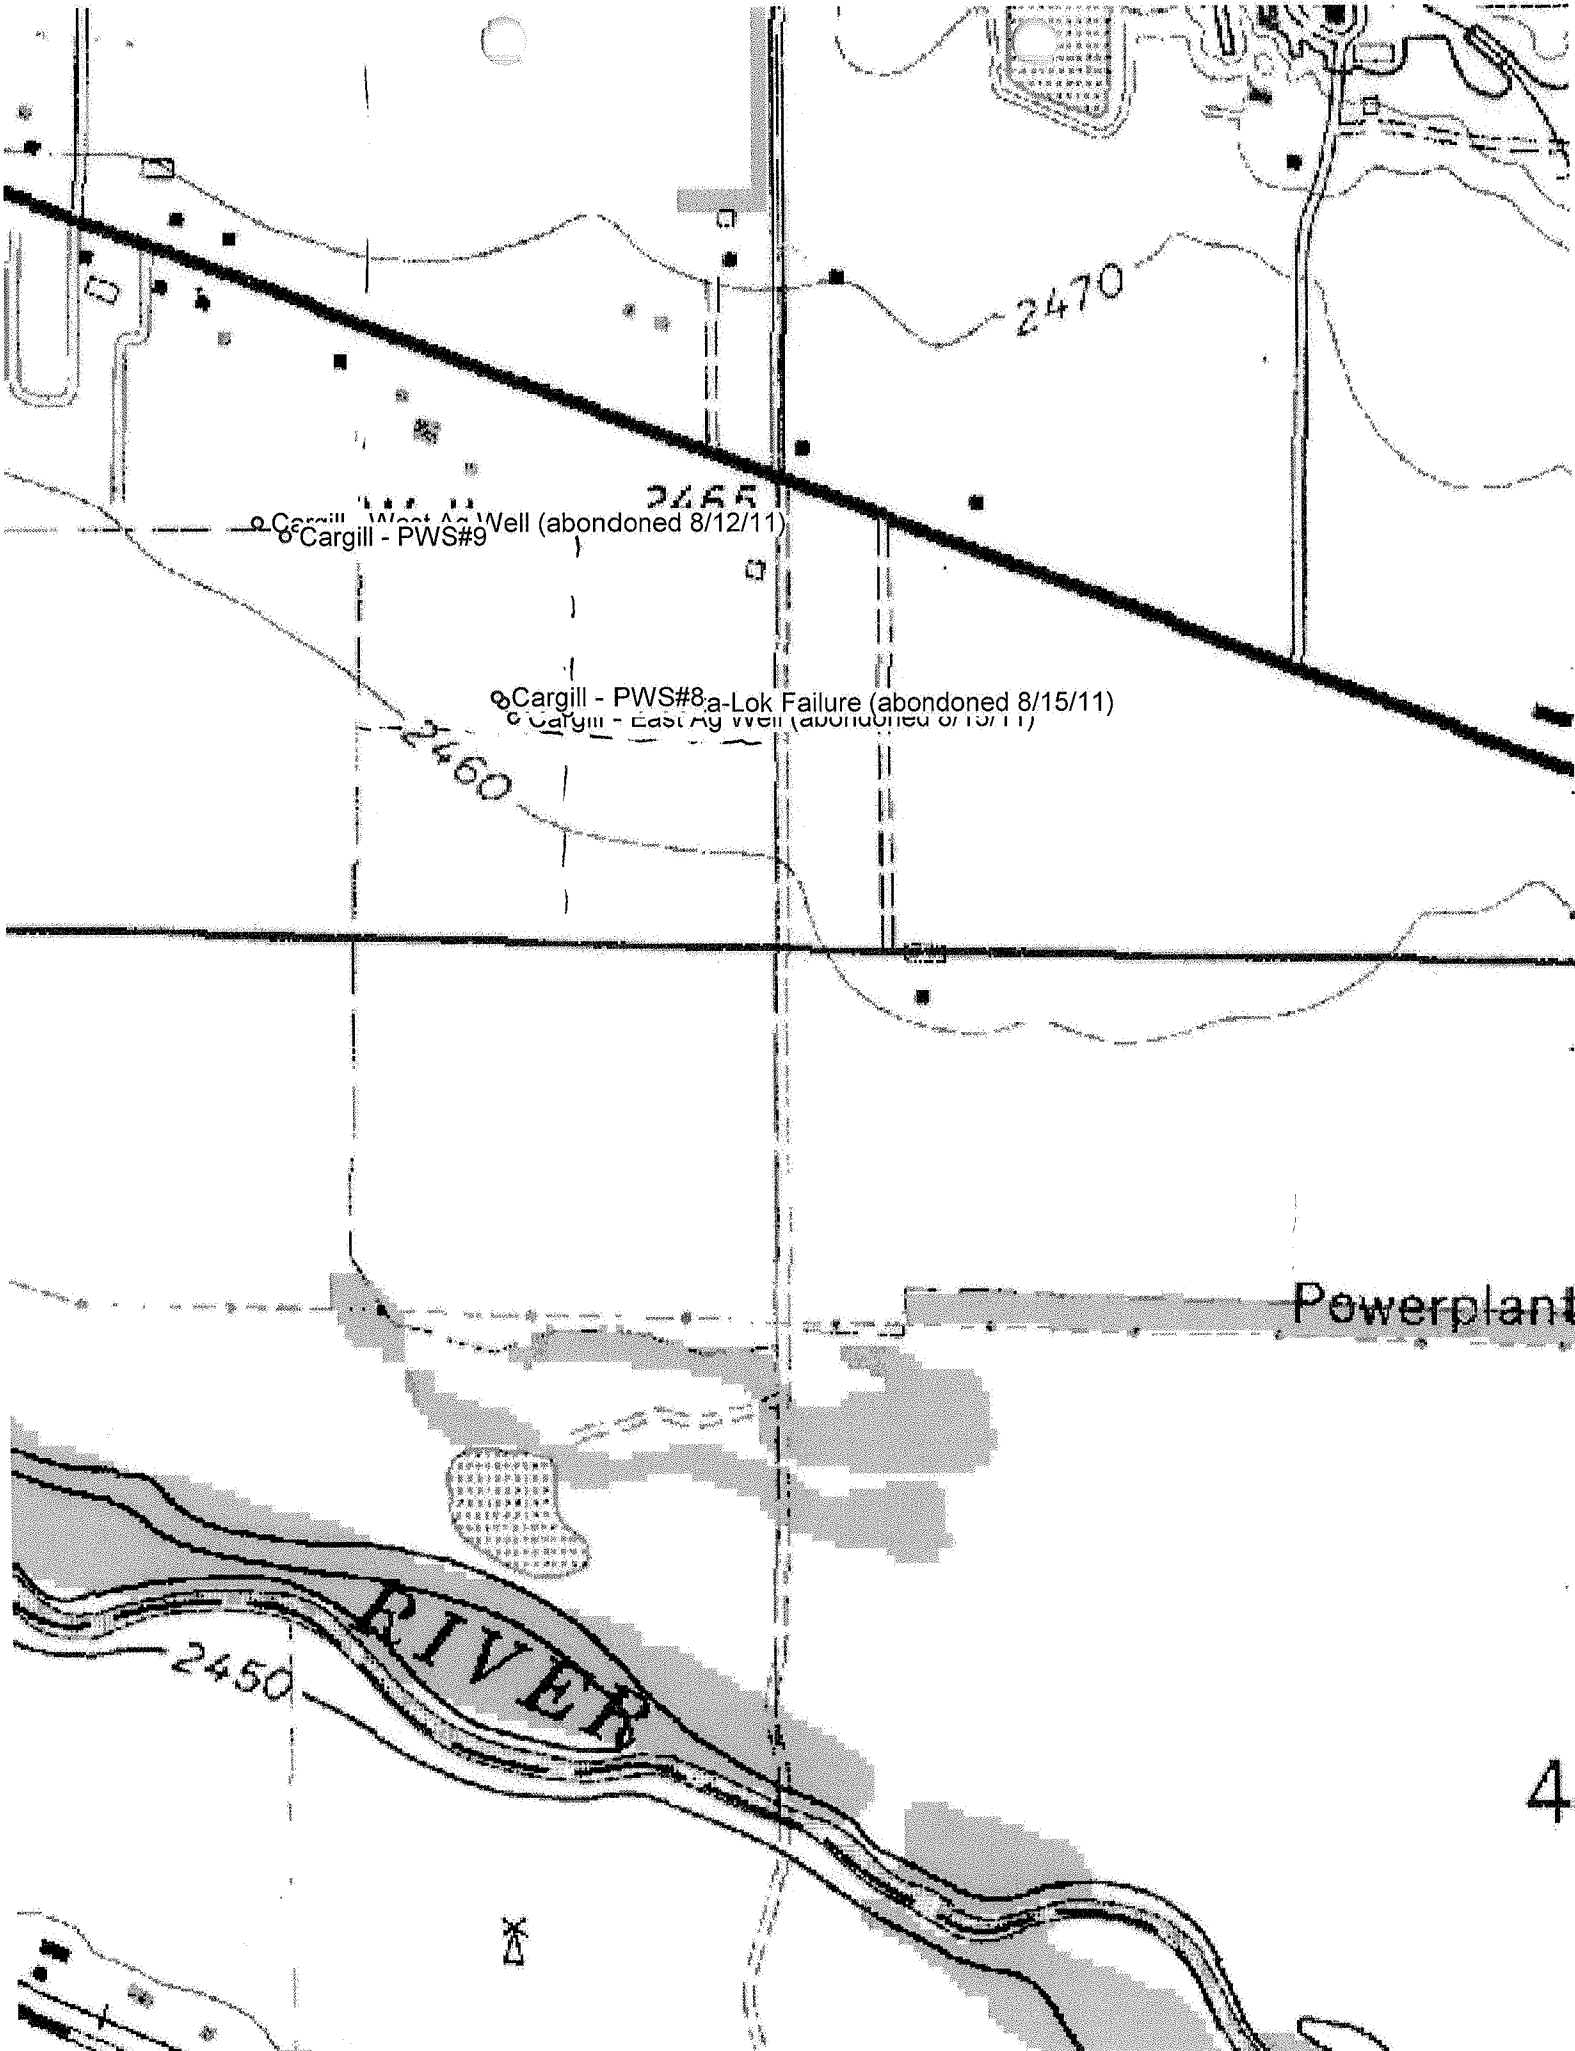



o Cargill - PWS#9

o Cargill - PWS#8a-Lok Failure (abandoned 8/15/11)

o Cargill - East Area Well (abandoned 8/15/11)


Powerplant

RIVER

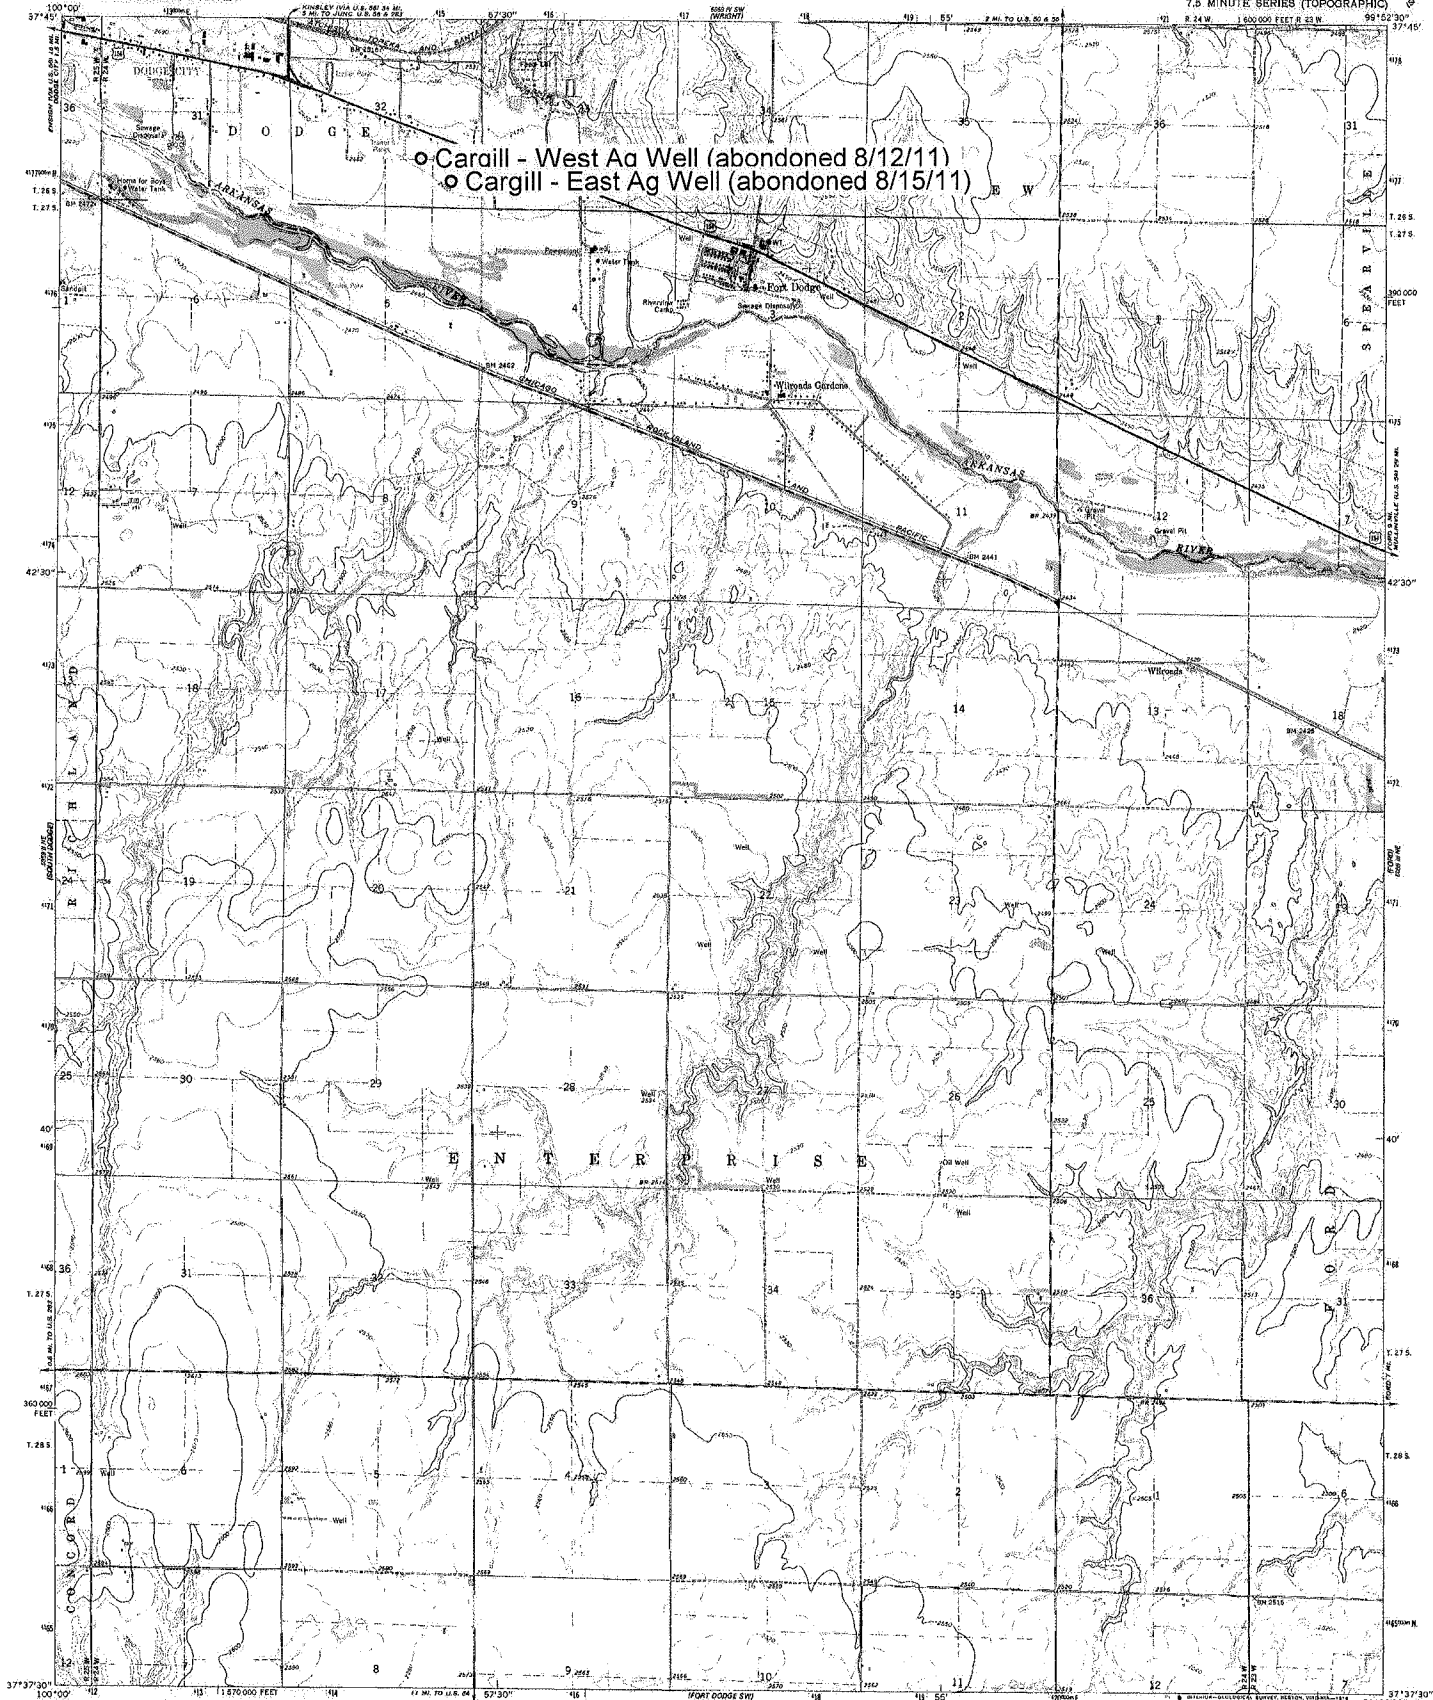

o Cargill - West Ag Well (abandoned 8/12/11)
o Cargill - East Ag Well (abandoned 8/15/11)

Mapped, edited, and published by the Geological Survey
Control by USGS and USC&GS
Topography by photogrammetric methods from aerial photographs taken 1955. Field checked 1969.
Polyconic projection. 1927 North American datum 10,000-foot grid based on Kansas coordinate system, south zone 1000-meter Universal Transverse Mercator grid ticks, zone 14, shown in blue.
Fine red dashed lines indicate selected fence and field lines where generally visible on aerial photographs. This information is unchecked.
Boundary lines for counties, cities, towns, and school districts shown 1977. Map dated 1978. Topographic data not field checked.

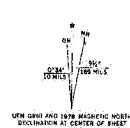

SCALE 1:24,000
CONTOUR INTERVAL 10 FEET
NATIONAL GEODETIC VERTICAL DATUM OF 1929

ROAD CLASSIFICATION
Primary highway, all weather, hard surface
Secondary highway, all weather, hard surface
Light duty road, all weather, improved surface
Unimproved road, fair or dry weather
U. S. Route

THIS MAP COMPLIES WITH NATIONAL MAP ACCURACY STANDARDS
FOR SALE BY U. S. GEOLOGICAL SURVEY, DENVER, COLORADO 80225, OR RESTON, VIRGINIA 22092
AND STATE GEOLOGICAL SURVEY, LAWRENCE, KANSAS 66044
A FOLDER DESCRIBING TOPOGRAPHIC MAPS AND SYMBOLS IS AVAILABLE ON REQUEST

FORT DODGE, KANS.
1965
