

WATER WELL RECORD Form WWC-5 1187395

1187395

Division of Water
Resources App. No.

Well ID

☐ Original Record ☐ Correction ☐ Change in Well Use[illegible]

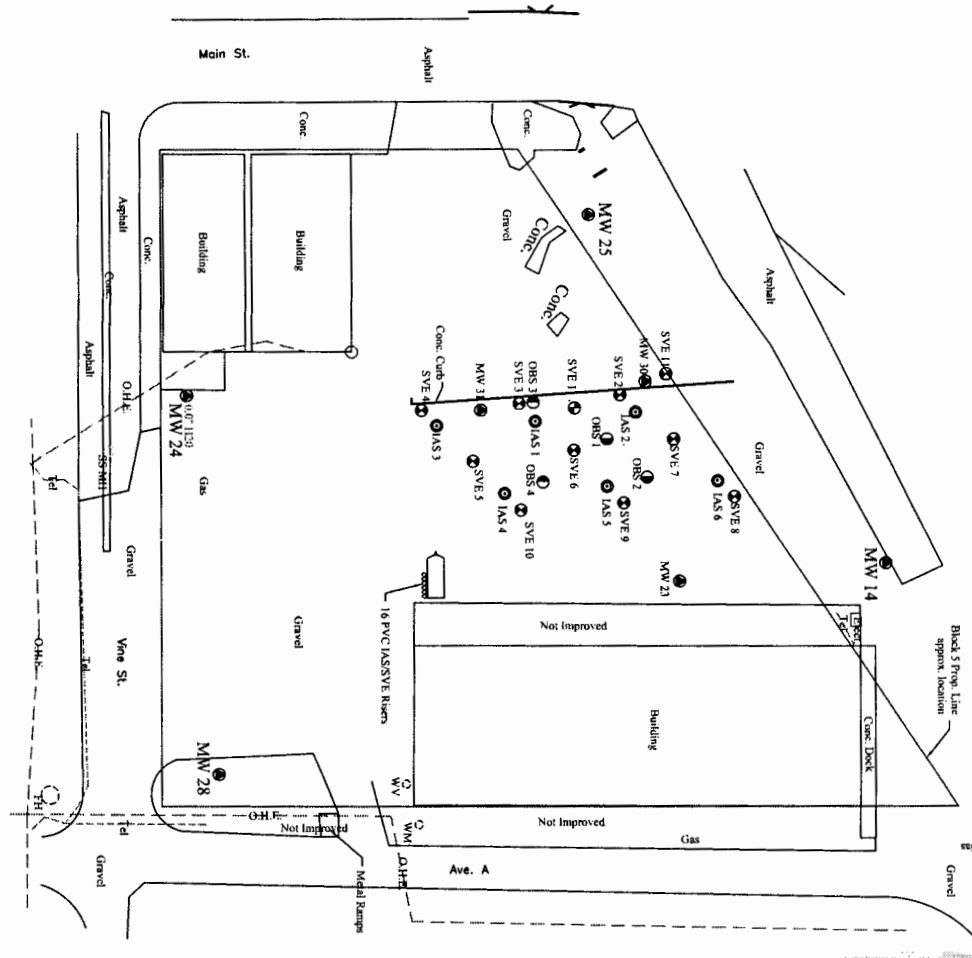


Fig 1B - Remediation Site Base Map
Right Coop
Wright, Kansas

Drawn By:	SGE II	Date:	
Reviewed By:	Sidney Edelbrock II, P.E.	KDHE Code:	A1-029-40375
Scale:	1 inch = 60 Feet	File:	Site Base Map.dwg

Legend

- - Right Coop Monitoring Well
- - CPA Monitoring Well
- - Sol Vent Well
- - IAS Well
- - Observation Well 4-inch Shallow
- - Observation Well 2-inch Deep
- - Nested IAS / SVE Well
- Gas - Gas Line
- O.H.E. - Overhead Electric Line
- V - Water Line
- SS - Sanitary Sewer Line
- Tel - Telephone Line
- - - Property Line
- B: 1390 - Concentration in ppb
- B: ND - Non-Detect
- - Isoconcentration Line
- B: NS - Not Sampled
- ▨ - Approximate Location of Former AST Bulk Storage Area

Scale In Feet
 0 60 120