

WATER WELL RECORD Form WWC-5 1185031

1185031

Division of Water
Resources App. No.

Well ID

☐ Original Record ☐ Correction ☐ Change in Well Use[illegible]

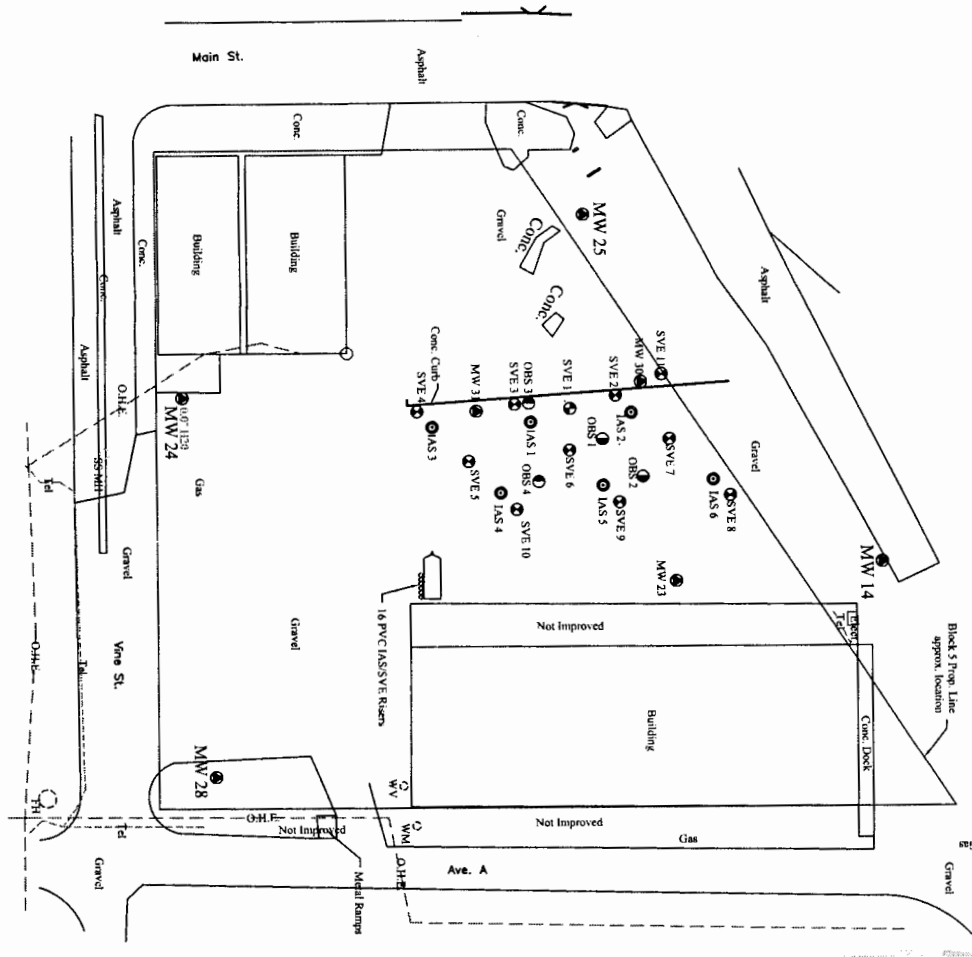


Fig 1B - Remediation Site Base Map
Right Coop
Wright, Kansas

Drawn By: SGE II	Date:
Reviewed By: Sidney Edelbrock II, P.E.	KDIE Code: A1-029-40375
Scale: 1 inch = 60 Feet	File: Site Base Map.dwg

Legend

- - Right Coop Monitoring Well
- - EPA Monitoring Well
- - Soil Vent Well
- - IAS Well
- - Observation Well 4-inch Shallow
- - Observation Well 2-inch Deep
- - Nested IAS / SVE Well
- Gas - Gas Line
- O.H.E. - Overhead Electric Line
- W - Water Line
- S.S. - Sanitary Sewer Line
- Tel - Telephone Line
- Prop - Property Line
- B: 1390 - Concentration in ppb
- B: ND - Non-Detect
- - Isoconcentration Line
- B: NS - Not Sampled
- ▨ - Approximate Location of Former AST Bulk Storage Area

