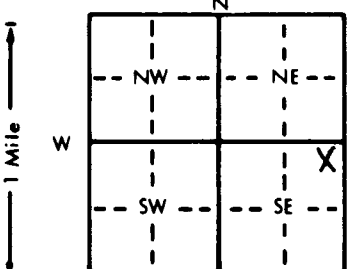


1 LOCATION OF WATER WELL: Fraction NE 1/4 NE 1/4 SE 1/4 Section Number 22 Township Number T 26 S Range Number R 24 EW

Distance and direction from nearest town or city street address of well if located within city?  
 3 1/2 miles East of Dodge City on Highway 50

2 WATER WELL OWNER: Farmland Industries  
 RR#, St. Address, Box #: P.O. Box 1337 Board of Agriculture, Division of Water Resources  
 City, State, ZIP Code: Dodge City, KS 67801-1337 Application Number:

3 LOCATE WELL'S LOCATION WITH AN "X" IN SECTION BOX:  4 DEPTH OF COMPLETED WELL: 277 ft. ELEVATION:  
 Depth(s) Groundwater Encountered 1. ft. 2. ft. 3. ft.  
 WELL'S STATIC WATER LEVEL 187.40 ft. below land surface measured on mo/day/yr  
 Pump test data: Well water was ft. after hours pumping gpm  
 Est. Yield gpm: Well water was ft. after hours pumping gpm  
 Bore Hole Diameter in. to ft., and in. to ft.  
 WELL WATER TO BE USED AS:  
 1 Domestic 3 Feedlot 6 Oil field water supply 9 Dewatering 12 Other (Specify below)  
 2 Irrigation 4 Industrial 7 Lawn and garden only 10 Monitoring well  
 Was a chemical/bacteriological sample submitted to Department? Yes No; If yes, mo/day/yr sample was submitted  
 Water Well Disinfected? Yes No

5 TYPE OF BLANK CASING USED:  
 1 Steel 3 RMP (SR) 5 Wrought iron 8 Concrete tile CASING JOINTS: Glued Clamped  
 2 PVC 4 ABS 6 Asbestos-Cement 9 Other (specify below) Welded  
 7 Fiberglass Threaded X  
 Blank casing diameter 6.0 in. to 237 ft., Dia. in. to ft., Dia. in. to ft.  
 Casing height above land surface 0.0 in., weight lbs./ft. Wall thickness or gauge No. Schedule 80  
 TYPE OF SCREEN OR PERFORATION MATERIAL:  
 1 Steel 3 Stainless steel 5 Fiberglass 7 PVC 10 Asbestos-cement  
 2 Brass 4 Galvanized steel 6 Concrete tile 8 RMP (SR) 11 Other (specify)  
 12 None used (open hole)  
 SCREEN OR PERFORATION OPENINGS ARE:  
 1 Continuous slot 3 Mill slot 5 Gauzed wrapped 8 Saw cut 11 None (open hole)  
 2 Louvered shutter 4 Key punched 6 Wire wrapped 9 Drilled holes  
 7 Torch cut 10 Other (specify)  
 SCREEN-PERFORATED INTERVALS: From 267 ft. to 237 ft. From ft. to ft.  
 From ft. to ft. From ft. to ft.  
 GRAVEL PACK INTERVALS: From 267 ft. to 230 ft. From ft. to ft.  
 From ft. to ft. From ft. to ft.

6 GROUT MATERIAL: 1 Neat cement 2 Cement grout 3 Bentonite 4 Other  
 Grout Intervals: From 380 ft. to 277 ft. From 230 ft. to 0.0 ft. From ft. to ft.  
 What is the nearest source of possible contamination:  
 1 Septic tank 4 Lateral lines 7 Pit privy 10 Livestock pens 14 Abandoned water well  
 2 Sewer lines 5 Cess pool 8 Sewage lagoon 11 Fuel storage 15 Oil well/Gas well  
 3 Watertight sewer lines 6 Seepage pit 9 Feedyard 12 Fertilizer storage 16 Other (specify below)  
 13 Insecticide storage  
 Direction from well? How many feet? 30

FROM	TO	LITHOLOGIC LOG	FROM	TO	PLUGGING INTERVALS
0	2	Gravel	260	280	Clay, Gray, Some Red, Lean
2	5	Clay, Med. Brown, Lean	280	280	Sand, Tan, Fine Grained
5	60	Clay, Med. Brown, Caliche, Hard	290	291	Clay, Red, Lean
60	75	Sand, Fine Grained, Tan	291	310	Sandstone, Dark Red, Fine Grained
75	90	Caliche, Sand-Fine Grained, Some Clay	310	320	Clay, Red, Lean
90	115	Clay, Brown, Lean, Some Caliche	320	328	Clay, Gray, Lean
115	120	Caliche	328	380	Sandstone, Fine Grained, Hard
120	155	Sand, Fine Grained, Some Caliche & Clay, Brown			
155	160	Clay, Maroon, Some Yellow, Lean			
160	170	Clay, Yellow, Lean			
170	180	Sand, Very Fine Grained			
180	190	Caliche, Some Sand, Fine Grained & some Red & Green Clay			
190	210	Clay, Red, Lean, Some Sand Fine Grained			
210	240	Clay, Gray & Red, Lean			
240	260	Sand, Fine Grained, Soft			

7 CONTRACTOR'S OR LANDOWNER'S CERTIFICATION: This water well was (1) constructed, (2) reconstructed, or (3) plugged under my jurisdiction and was completed on (mo/day/year) 9/19/94 and this record is true to the best of my knowledge and belief. Kansas Water Well Contractor's License No. 540 This Water Well Record was completed on (mo/day/yr) 9-23-94 under the business name of Prairie Land Environmental Remediation, Inc. (signature) J.S. Mill