


1 LOCATION OF WATER WELL: Fraction 1/4 S1/2 1/4 SW 1/4 Section Number 20 Township Number T 26 S Range Number R 24 EW
 County: Ford

Distance and direction from nearest town or city street address of well if located within city?
2 miles North of Dodge City

2 WATER WELL OWNER: Ford County Landfill
 RR#, St. Address, Box #: Jetmore Star Route Board of Agriculture, Division of Water Resources
 City, State, ZIP Code: Dodge City, Ks. 67801 2D Application Number:

3 LOCATE WELL'S LOCATION WITH AN "X" IN SECTION BOX:

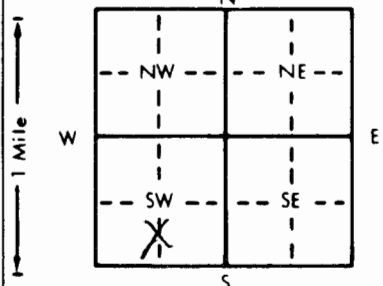

4 DEPTH OF COMPLETED WELL: 230 ft. ELEVATION:

Depth(s) Groundwater Encountered 1. _____ ft. 2. _____ ft. 3. _____ ft.
 WELL'S STATIC WATER LEVEL 129.87 ft. below land surface measured on mo/day/yr
 Pump test data: Well water was _____ ft. after _____ hours pumping _____ gpm
 Est. Yield _____ gpm: Well water was _____ ft. after _____ hours pumping _____ gpm
 Bore Hole Diameter: 8 in. to 230 ft., and _____ in. to _____ ft.
 WELL WATER TO BE USED AS:
 5 Public water supply 8 Air conditioning 11 Injection well
 1 Domestic 3 Feedlot 6 Oil field water supply 9 Dewatering 12 Other (Specify below)
 2 Irrigation 4 Industrial 7 Lawn and garden only 10 Monitoring well _____
 Was a chemical/bacteriological sample submitted to Department? Yes _____ No X; If yes, mo/day/yr sample was submitted
 Water Well Disinfected? Yes _____ No X

5 TYPE OF BLANK CASING USED:
 1 Steel 3 RMP (SR) 5 Wrought iron 8 Concrete tile CASING JOINTS: Glued _____ Clamped _____
 2 PVC 4 ABS 6 Asbestos-Cement 9 Other (specify below) Welded _____
 7 Fiberglass _____ Threaded _____

Blank casing diameter 4 in. to 210 ft., Dia _____ in. to _____ ft., Dia _____ in. to _____ ft.
 Casing height above land surface 30 in., weight 2.071 lbs./ft. Wall thickness or gauge No. .237

TYPE OF SCREEN OR PERFORATION MATERIAL:
 1 Steel 3 Stainless steel 5 Fiberglass 7 PVC 10 Asbestos-cement
 2 Brass 4 Galvanized steel 6 Concrete tile 8 RMP (SR) 11 Other (specify) _____
 12 None used (open hole)

SCREEN OR PERFORATION OPENINGS ARE:
 1 Continuous slot 3 Mill slot 5 Gauzed wrapped 8 Saw cut 11 None (open hole)
 2 Louvered shutter 4 Key punched 6 Wire wrapped 9 Drilled holes
 7 Torch cut 10 Other (specify) _____

SCREEN-PERFORATED INTERVALS: From 210 ft. to 230 ft., From _____ ft. to _____ ft.
 From _____ ft. to _____ ft., From _____ ft. to _____ ft.
 GRAVEL PACK INTERVALS: From 205 ft. to 230 ft., From _____ ft. to _____ ft.
 From _____ ft. to _____ ft., From _____ ft. to _____ ft.

6 GROUT MATERIAL: 1 Neat cement 2 Cement grout 3 Bentonite 4 Other _____
 Grout Intervals: From 0 ft. to 196 ft., From 196 ft. to 205 ft., From _____ ft. to _____ ft.

What is the nearest source of possible contamination:
 1 Septic tank 4 Lateral lines 7 Pit privy 10 Livestock pens 14 Abandoned water well
 2 Sewer lines 5 Cess pool 8 Sewage lagoon 11 Fuel storage 15 Oil well/Gas well
 3 Watertight sewer lines 6 Seepage pit 9 Feedyard 12 Fertilizer storage 16 Other (specify below) Landfill
 13 Insecticide storage

Direction from well? _____ How many feet? _____

FROM	TO	LITHOLOGIC LOG	FROM	TO	PLUGGING INTERVALS
0	3.5	Surface	130	138	Med. Sand/Caliche Strks.
3.5	10	Loess	138	140	Clay
10	35	Tan Clay w/Caliche Strks.	140	145	Clay, Cemented Sand&Caliche
35	50	Clay/Caliche Lenses	145	155	Silty Fine Sand
50	55	Caliche & Clay Strks.	155	173	Loose Fine Sand
55	65	Caliche/Clay & Sand Strks.	173	187	Silty, Sandy, Sticky Clay
65	80	Caliche & Clay Strks.	187	200	Fine to Med. Sand
80	85	Caliche & Sandy Clay	200	205	Med. Sand/Clay & Caliche Strk
85	89	Clay & Sand	205	215	Med. To Coarse Sand
89	90	Caliche	215	219	Sandy Clay
90	95	Sandy Clay & Fine Sand Strks.	219	222	Med. To Coarse Sand
95	100	Sandy Clay & Caliche	222	230	Gray Clay w/Possible Weather ed Shale
100	105	Silty Clay Caliche & Fine Sand			
105	115	Clay & Caliche Str.			
115	130	Clay, Caliche & Sand Strks.s			

7 CONTRACTOR'S OR LANDOWNER'S CERTIFICATION: This water well was (1) constructed, (2) reconstructed, or (3) plugged under my jurisdiction and was completed on (mo/day/year) 9-6-94 and this record is true to the best of my knowledge and belief. Kansas Water Well Contractor's License No. 554 This Water Well Record was completed on (mo/day/yr) 9-21-94 under the business name of Woofter Pump & Well, Inc. by (signature) Jay C. Woofter