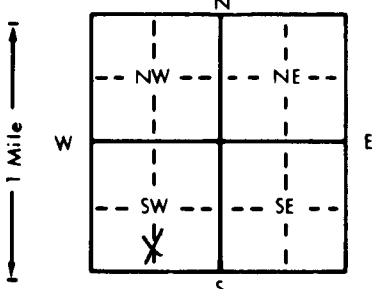


1 LOCATION OF WATER WELL: Fraction  $\frac{1}{4}$  S  $\frac{1}{2}$   $\frac{1}{4}$  SW  $\frac{1}{4}$  Section Number 20 Township Number T 26 S Range Number R 24 EW

Distance and direction from nearest town or city street address of well if located within city?  
 2 miles North of Dodge City

2 WATER WELL OWNER: Ford County Landfill  
 RR#, St. Address, Box #: Jetmore Star Route Board of Agriculture, Division of Water Resources  
 City, State, ZIP Code: Dodge City, Ks. 67801 8D Application Number:

3 LOCATE WELL'S LOCATION WITH AN "X" IN SECTION BOX:  

 4 DEPTH OF COMPLETED WELL: 222 ft. ELEVATION:  
 Depth(s) Groundwater Encountered 1. ft. 2. ft. 3. ft.  
 WELL'S STATIC WATER LEVEL 134.10 ft. below land surface measured on mo/day/yr  
 Pump test data: Well water was . . . . . ft. after . . . . . hours pumping . . . . . gpm  
 Est. Yield . . . . . gpm: Well water was . . . . . ft. after . . . . . hours pumping . . . . . gpm  
 Bore Hole Diameter . . . . . 8 in. to . . . . . 222 ft., and . . . . . in. to . . . . . ft.  
 WELL WATER TO BE USED AS:  
 5 Public water supply 8 Air conditioning 11 Injection well  
 1 Domestic 3 Feedlot 6 Oil field water supply 9 Dewatering 12 Other (Specify below)  
 2 Irrigation 4 Industrial 7 Lawn and garden only 10 Monitoring well  
 Was a chemical/bacteriological sample submitted to Department? Yes . . . . . No ; If yes, mo/day/yr sample was sub-  
 mitted  
 Water Well Disinfected? Yes No

5 TYPE OF BLANK CASING USED:  
 1 Steel 3 RMP (SR) 5 Wrought iron 8 Concrete tile CASING JOINTS: Glued . . . . . Clamped . . . . .  
 2 PVC 4 ABS 6 Asbestos-Cement 9 Other (specify below) Welded . . . . .  
 7 Fiberglass Threaded   
 Blank casing diameter . . . . . 4 in. to . . . . . 202 ft., Dia . . . . . in. to . . . . . ft., Dia . . . . . in. to . . . . . ft.  
 Casing height above land surface . . . . . 30 in., weight . . . . . 2.071 lbs./ft. Wall thickness or gauge No. . . . . 237  
 TYPE OF SCREEN OR PERFORATION MATERIAL:  
 1 Steel 3 Stainless steel 5 Fiberglass 8 RMP (SR) 10 Asbestos-cement 11 Other (specify) . . . . .  
 2 Brass 4 Galvanized steel 6 Concrete tile 9 ABS 12 None used (open hole)  
 SCREEN OR PERFORATION OPENINGS ARE:  
 1 Continuous slot 3 Mill slot 5 Gauzed wrapped 8 Saw cut 11 None (open hole)  
 2 Louvered shutter 4 Key punched 6 Wire wrapped 9 Drilled holes  
 7 Torch cut 10 Other (specify) . . . . .  
 SCREEN-PERFORATED INTERVALS: From . . . . . 202 ft. to . . . . . 222 ft., From . . . . . ft. to . . . . . ft.  
 From . . . . . ft. to . . . . . ft., From . . . . . ft. to . . . . . ft.  
 GRAVEL PACK INTERVALS: From . . . . . 196 ft. to . . . . . 222 ft., From . . . . . ft. to . . . . . ft.  
 From . . . . . ft. to . . . . . ft., From . . . . . ft. to . . . . . ft.

6 GROUT MATERIAL: 1 Neat cement 2 Cement grout 3 Bentonite 4 Other . . . . .  
 Grout Intervals: From . . . . . 0 ft. to . . . . . 188 ft., From . . . . . 188 ft. to . . . . . 196 ft., From . . . . . ft. to . . . . . ft.  
 What is the nearest source of possible contamination:  
 1 Septic tank 4 Lateral lines 7 Pit privy 10 Livestock pens 14 Abandoned water well  
 2 Sewer lines 5 Cess pool 8 Sewage lagoon 11 Fuel storage 15 Oil well/Gas well  
 3 Watertight sewer lines 6 Seepage pit 9 Feedyard 12 Fertilizer storage 16 Other (specify below)  
 13 Insecticide storage Landfill  
 Direction from well? How many feet?

FROM	TO	LITHOLOGIC LOG	FROM	TO	PLUGGING INTERVALS
0	2	Surface	138	140	Fine Sand/Few Caliche Strks.
2	18	Loess	140	154	Fine Sand w/Fine Clay Lyrs
18	20	Clay	154	160	Fine to Med. Sand w/Clay
20	40	Clay w/Caliche	160	164	Med.Sand Strks.
40	50	Caliche w/Fine Clay Lenses	164	170	Sandy Clay w/Caliche Strks.
50	55	Clay w/Caliche Strks.	170	175	Sandy Clay w/fine Sand.Strks
55	60	Med. Sand w/Cemented Sand & Some Caliche	175	178	Sandy Clay
60	77	Cemented Sand, Caliche, Clay	178	180	Med. Sand w/Clay Strks.
77	80	Sandy Clay w/Some Sand	180	181	Sandy Clay
80	85	Med. Sand w/a Few Caliche St.	181	190	Fine to Med. Sand w/Clay.St.
85	105	Sandy Clay w/Cemented Sand	190	206	Med. Sand & Gravel
105	115	Caliche w/fine Clay Lenses	206	215	Sandy Clay w/a Little Sand
115	125	Caliche w/Sandy Strk & Clay	215	216.5	Sandy Clay
125	138	Sandy Clay w/Caliche Strks.	216.5	217	Med. Sand
			217	222	Sandy Clay/Ochre Strks.

7 CONTRACTOR'S OR LANDOWNER'S CERTIFICATION: This water well was (1) constructed, (2) reconstructed, or (3) plugged under my jurisdiction and was completed on (mo/day/year) . . . . . 9-12-94 . . . . . and this record is true to the best of my knowledge and belief. Kansas Water Well Contractor's License No. 554 . . . . . This Water Well Record was completed on (mo/day/yr) 9-21-94 . . . . . under the business name of Woofter Pump & Well, Inc. by (signature) *Jay G. Woofter*